
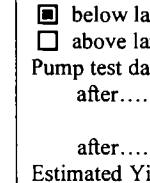


☒ Original Record ☐ Correction ☐ Change in Well Use

Well ID

MW13

1 LOCATION OF WATER WELL: County: <u>Washington</u> <u>Clay</u> (KGS)		Fraction <u>NE ¼ NW ¼ NW ¼ NE ¼</u>	Section Number <u>2</u>	Township Number <u>T 6 S</u>	Range Number <u>R 1 E W</u>
2 WELL OWNER: Last Name: <u>Kramer</u> Business: <u>Kramer Oil Co., Inc.</u> Address: <u>PO Box 343</u> City: <u>Marysville</u> State: <u>KS</u> ZIP: <u>66508</u>		First: <u>Chad</u>	Street or Rural Address where well is located (if unknown, distance and direction from nearest town or intersection): If at owner's address, check here: <input type="checkbox"/> <u>204 E Parallel St</u> <u>Clifton, KS 66937</u>		
3 LOCATE WELL WITH "X" IN SECTION BOX: N W E S -----1 mile----- 	4 DEPTH OF COMPLETED WELL: <u>25</u> ft. Depth(s) Groundwater Encountered: 1) <u>17</u> ft. 2) ft. 3) ft., or 4) <input type="checkbox"/> Dry Well WELL'S STATIC WATER LEVEL: ft. <input checked="" type="checkbox"/> below land surface, measured on (mo-day-yr)..... <u>6/23/21</u> <input type="checkbox"/> above land surface, measured on (mo-day-yr)..... Pump test data: Well water was ft. after..... hours pumping gpm Well water was ft. after..... hours pumping gpm Estimated Yield: gpm Bore Hole Diameter: <u>8.5</u> in. to <u>25</u> ft. and in. to ft.		5 Latitude: <u>39.56630</u>(decimal degrees) Longitude: <u>97.28252</u>(decimal degrees) Horizontal Datum: <input type="checkbox"/> WGS 84 <input checked="" type="checkbox"/> NAD 83 <input type="checkbox"/> NAD 27 <u>Source for Latitude/Longitude:</u> <input type="checkbox"/> GPS (unit make/model:) (WAAS enabled? <input type="checkbox"/> Yes <input type="checkbox"/> No) <input checked="" type="checkbox"/> Land Survey <input type="checkbox"/> Topographic Map <input type="checkbox"/> Online Mapper:		
			6 Elevation: <u>1271.17</u>ft. <input type="checkbox"/> Ground Level <input checked="" type="checkbox"/> TOC <u>Source:</u> <input checked="" type="checkbox"/> Land Survey <input type="checkbox"/> GPS <input type="checkbox"/> Topographic Map <input type="checkbox"/> Other		
7 WELL WATER TO BE USED AS: 1. Domestic: <input type="checkbox"/> Household <input type="checkbox"/> Lawn & Garden <input type="checkbox"/> Livestock 2. <input type="checkbox"/> Irrigation 3. <input type="checkbox"/> Feedlot 4. <input type="checkbox"/> Industrial 5. <input type="checkbox"/> Public Water Supply: well ID 6. <input type="checkbox"/> Dewatering: how many wells? 7. <input type="checkbox"/> Aquifer Recharge: well ID 8. <input checked="" type="checkbox"/> Monitoring: well ID <u>MW13</u> 9. Environmental Remediation: well ID <input type="checkbox"/> Air Sparge <input type="checkbox"/> Soil Vapor Extraction <input type="checkbox"/> Recovery <input type="checkbox"/> Injection 10. <input type="checkbox"/> Oil Field Water Supply: lease 11. Test Hole: well ID <input type="checkbox"/> Cased <input type="checkbox"/> Uncased <input type="checkbox"/> Geotechnical 12. Geothermal: how many bores? a) Closed Loop <input type="checkbox"/> Horizontal <input type="checkbox"/> Vertical b) Open Loop <input type="checkbox"/> Surface Discharge <input type="checkbox"/> Inj. of Water 13. <input type="checkbox"/> Other (specify):					
Was a chemical/bacteriological sample submitted to KDHE? <input type="checkbox"/> Yes <input checked="" type="checkbox"/> No If yes, date sample was submitted: Water well disinfected? <input type="checkbox"/> Yes <input checked="" type="checkbox"/> No					
8 TYPE OF CASING USED: <input type="checkbox"/> Steel <input checked="" type="checkbox"/> PVC <input type="checkbox"/> Other CASING JOINTS: <input type="checkbox"/> Glued <input type="checkbox"/> Clamped <input type="checkbox"/> Welded <input checked="" type="checkbox"/> Threaded Casing diameter <u>2</u> in. to <u>25</u> ft., Diameter in. to ft., Diameter in. to ft. Casing height above land surface in. Weight lbs./ft. Wall thickness or gauge No. <u>40</u> TYPE OF SCREEN OR PERFORATION MATERIAL: <input type="checkbox"/> Steel <input type="checkbox"/> Stainless Steel <input type="checkbox"/> Fiberglass <input checked="" type="checkbox"/> PVC <input type="checkbox"/> Other (Specify) <input type="checkbox"/> Brass <input type="checkbox"/> Galvanized Steel <input type="checkbox"/> Concrete tile <input type="checkbox"/> None used (open hole) SCREEN OR PERFORATION OPENINGS ARE: <input type="checkbox"/> Continuous Slot <input checked="" type="checkbox"/> Mill Slot <input type="checkbox"/> Gauze Wrapped <input type="checkbox"/> Torch Cut <input type="checkbox"/> Drilled Holes <input type="checkbox"/> Other (Specify) <input type="checkbox"/> Louvered Shutter <input type="checkbox"/> Key Punched <input type="checkbox"/> Wire Wrapped <input type="checkbox"/> Saw Cut <input type="checkbox"/> None (Open Hole) SCREEN-PERFORATED INTERVALS: From <u>15</u> ft. to <u>25</u> ft., From ft. to ft., From ft. to ft. GRAVEL PACK INTERVALS: From <u>13</u> ft. to <u>25</u> ft., From ft. to ft., From ft. to ft.					
9 GROUT MATERIAL: <input type="checkbox"/> Neat cement <input type="checkbox"/> Cement grout <input checked="" type="checkbox"/> Bentonite <input type="checkbox"/> Other <u>0-1 Concrete</u> Grout Intervals: From <u>1</u> ft. to <u>13</u> ft., From ft. to ft., From ft. to ft. Nearest source of possible contamination: <input type="checkbox"/> Septic Tank <input type="checkbox"/> Lateral Lines <input type="checkbox"/> Pit Privy <input type="checkbox"/> Livestock Pens <input type="checkbox"/> Insecticide Storage <input type="checkbox"/> Sewer Lines <input type="checkbox"/> Cess Pool <input type="checkbox"/> Sewage Lagoon <input checked="" type="checkbox"/> Fuel Storage <input type="checkbox"/> Abandoned Water Well <input type="checkbox"/> Watertight Sewer Lines <input type="checkbox"/> Seepage Pit <input type="checkbox"/> Feedyard <input type="checkbox"/> Fertilizer Storage <input type="checkbox"/> Oil Well/Gas Well <input type="checkbox"/> Other (Specify) Direction from well? <u>Northwest</u> Distance from well? <u>280</u> ft.					
10 FROM TO LITHOLOGIC LOG 0 1 Topsoil, silty clay loam 1 25 Silty clay		FROM TO LITHO. LOG (cont.) or PLUGGING INTERVALS 			
		Notes: Clifton Cardlock U5-101-15172 Clifton, KS 66937			
11 CONTRACTOR'S OR LANDOWNER'S CERTIFICATION: This water well was <input checked="" type="checkbox"/> constructed, <input type="checkbox"/> reconstructed, or <input type="checkbox"/> plugged under my jurisdiction and was completed on (mo-day-year) <u>6/22/21</u> and this record is true to the best of my knowledge and belief. Kansas Water Well Contractor's License No. <u>585</u> This Water Well Record was completed on (mo-day-year) <u>7/21/21</u> under the business name of <u>Associated Environmental, Inc.</u> Signature <u>[Signature]</u>					
Mail 1 white copy along with a fee of \$5.00 for each constructed well to: Kansas Department of Health and Environment, Bureau of Water, GWTS Section, 1000 SW Jackson St., Suite 420, Topeka, Kansas 66612-1367. Mail one to Water Well Owner and retain one for your records. Telephone 785-296-5524. Visit us at http://www.kdheks.gov/waterwell/index.html KSA 82a-1212 Revised 7/10/2015					

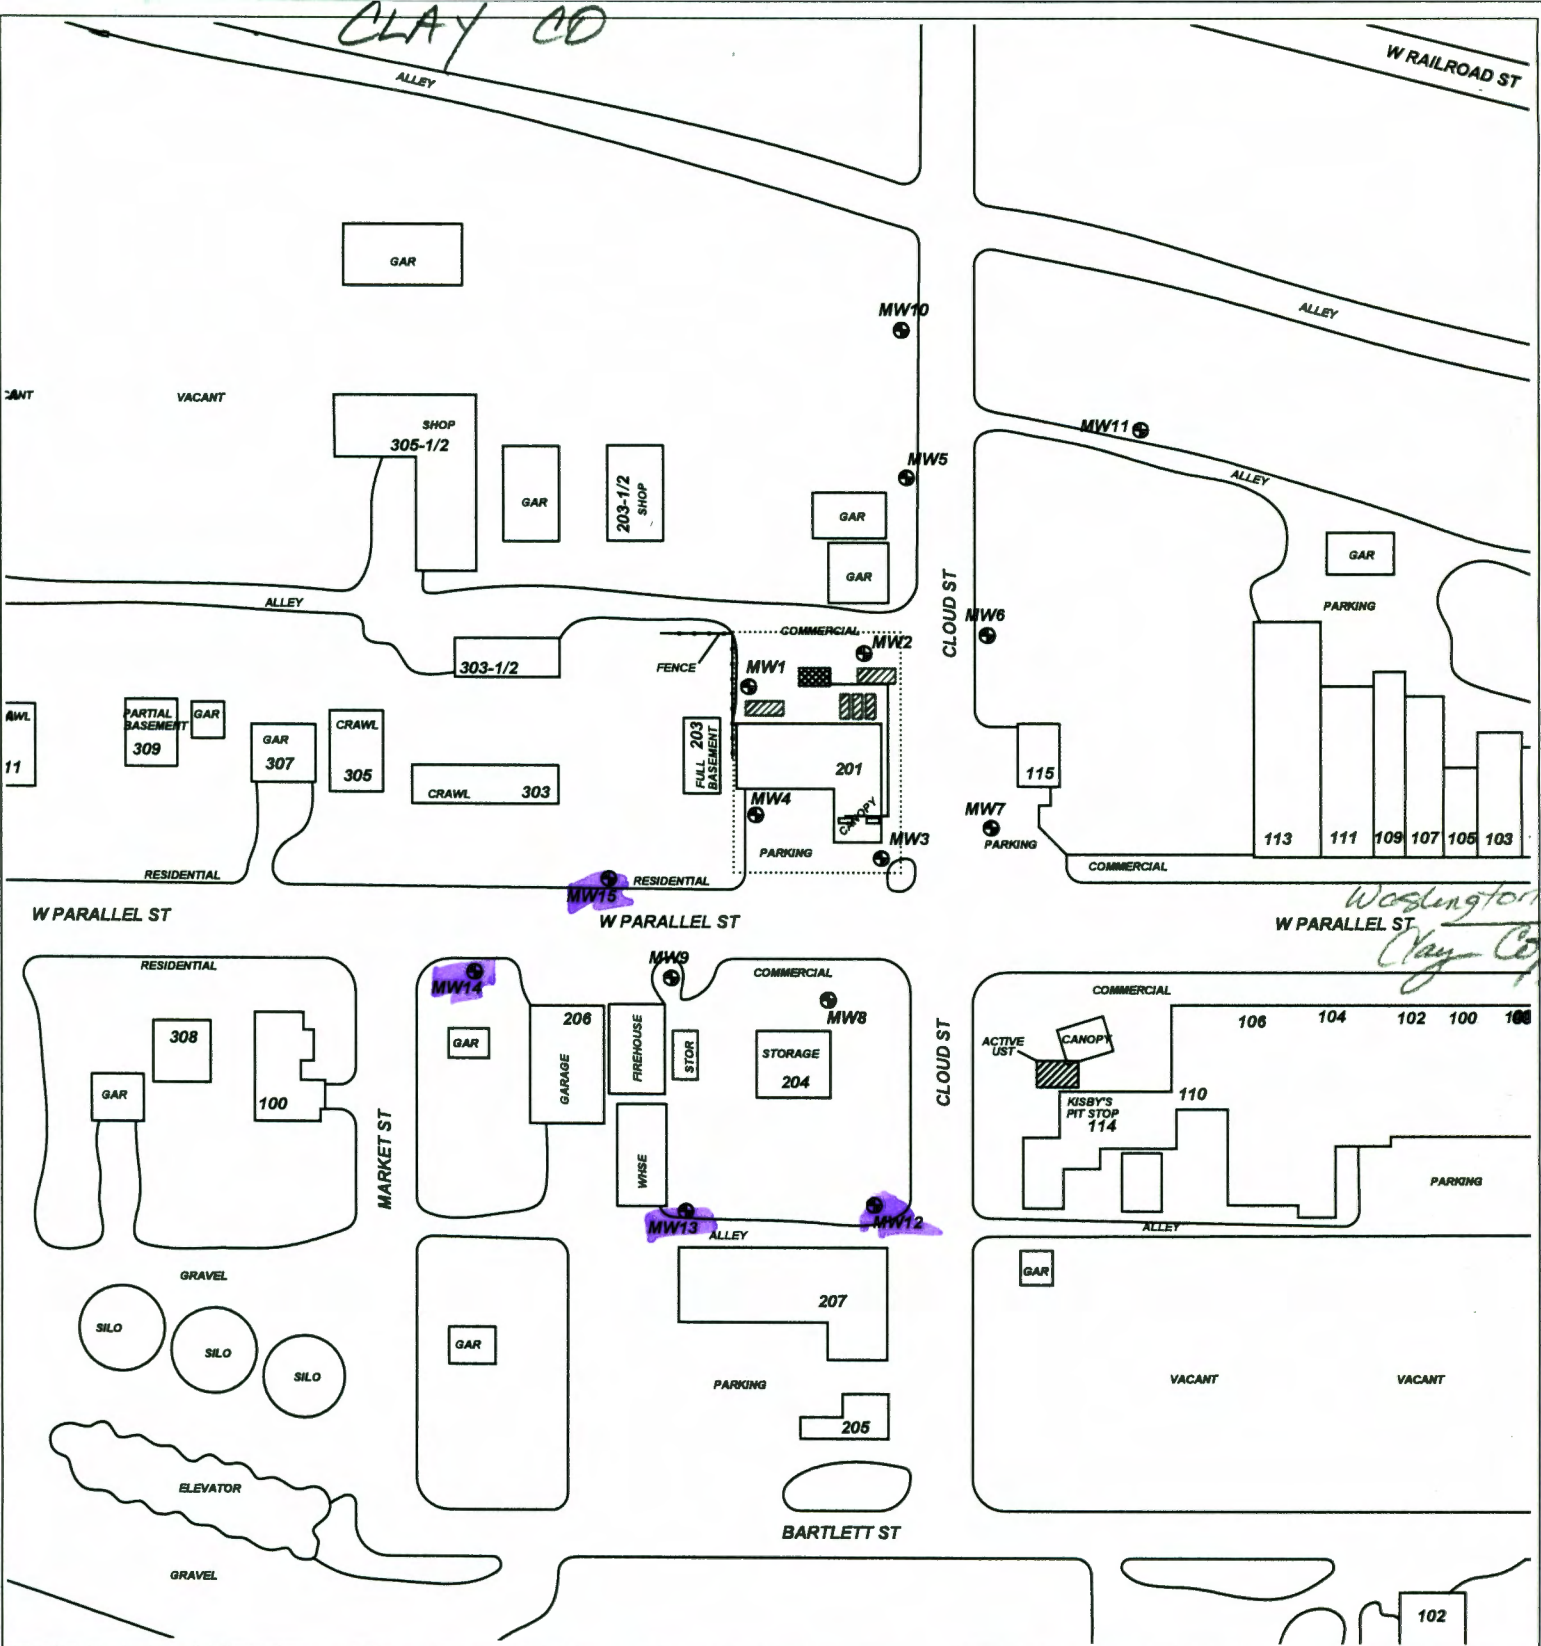

PROJECT: CLIFTON CARDLOCK

ADDRESS: 201 W. PARALLEL ST.

LOCATION: CLIFTON, KS

DRAWN BY: C. ROE **DATE:** 1/15/20

REVISED BY: B. STALNAKER **DATE:** 7/19/21

AEI JOB #: TF521 **KDHE JOB #:** U5-101-15172

TITLE:

FIGURE 2.1


AREA BASE MAP

350' RADIUS

ASSOCIATED ENVIRONMENTAL INC.

LEGEND:

- = FORMER USTS
- = ACTIVE AST, FUEL LINES AND PUMP ISLANDS
- = MONITORING WELL
- = SUBJECT PROPERTY

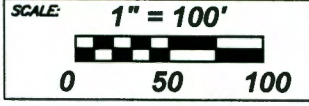

NOTES: