

WATER WELL RECORD Form WWC-5

☒ Original Record ☐ Correction ☐ Change in Well Use

Division of Water
Resources App. No.

Well ID

MW17

1 LOCATION OF WATER WELL:


Section Number
2

Township Number
T 6 S

Range Number
R 1 ☒ E ☐ W

2 WELL OWNER: Last Name: Kramer

First: Chad

Street or Rural Address where well is located (if unknown, distance and direction from nearest town or intersection): If at owner's address, check here: ☐

Business: Kramer Oil Co., Inc.

Address: PO Box 343

Address:


City: Marvsville

State: KS

ZIP: 66508

204 E Parallel St
Clifton, KS 66937

3 LOCATE WELL WITH "X" IN SECTION BOX:

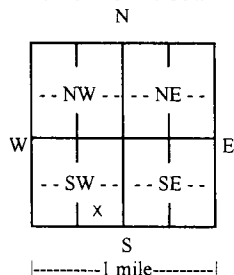

4 DEPTH OF COMPLETED WELL: 25 ft.

Depth(s) Groundwater Encountered: 1) 15 ft.

2) 17.40 ft. 3) 17.40 ft. or 4) ☐ Dry Well

WELL'S STATIC WATER LEVEL: 17.40 ft.

☒ below land surface, measured on (mo-day-yr) 12/16/21

☐ above land surface, measured on (mo-day-yr) 12/16/21






Bore Hole Diameter: 8.5 in. to 25 ft. and

8.5 in. to 25 ft.

5 Latitude: 39.56584 (decimal degrees)

Longitude: 97.28260 (decimal degrees)

Horizontal Datum: ☐ WGS 84 ☒ NAD 83 ☐ NAD 27

Source for Latitude/Longitude:

☐ GPS (unit make/model: Garmin)

(WAAS enabled? ☐ Yes ☐ No)

☒ Land Survey ☐ Topographic Map

☐ Online Mapper: Google Earth

6 Elevation: 1267.38 ft. ☐ Ground Level ☒ TOC

Source: ☒ Land Survey ☐ GPS ☐ Topographic Map

☐ Other None

7 WELL WATER TO BE USED AS:

1. Domestic:

- ☐ Household
☐ Lawn & Garden
☐ Livestock

2. ☐ Irrigation

3. ☐ Feedlot

4. ☐ Industrial

5. ☐ Public Water Supply: well ID

6. ☐ Dewatering: how many wells?

7. ☐ Aquifer Recharge: well ID

8. ☒ Monitoring: well ID MW17

9. Environmental Remediation: well ID

☐ Air Sparge ☐ Soil Vapor Extraction

☐ Recovery ☐ Injection

10. ☐ Oil Field Water Supply: lease

11. Test Hole: well ID

☐ Cased ☐ Uncased ☐ Geotechnical

12. Geothermal: how many bores?

a) Closed Loop ☐ Horizontal ☐ Vertical

b) Open Loop ☐ Surface Discharge ☐ Inj. of Water

13. ☐ Other (specify):

Was a chemical/bacteriological sample submitted to KDHE? ☐ Yes ☒ No If yes, date sample was submitted:

Water well disinfected? ☐ Yes ☒ No

8 TYPE OF CASING USED: ☐ Steel ☒ PVC ☐ Other CASING JOINTS: ☐ Glued ☐ Clamped ☐ Welded ☒ Threaded

Casing diameter 2 in. to 25 ft. Diameter in. to ft. Diameter in. to ft.

Casing height above land surface in. Weight lbs./ft. Wall thickness or gauge No. 40

TYPE OF SCREEN OR PERFORATION MATERIAL:

☐ Steel ☐ Stainless Steel ☐ Fiberglass ☒ PVC ☐ Other (Specify)

☐ Brass ☐ Galvanized Steel ☐ Concrete tile ☐ None used (open hole)

SCREEN OR PERFORATION OPENINGS ARE:

☐ Continuous Slot ☒ Mill Slot ☐ Gauze Wrapped ☐ Torch Cut ☐ Drilled Holes ☐ Other (Specify)

☐ Louvered Shutter ☐ Key Punched ☐ Wire Wrapped ☐ Saw Cut ☐ None (Open Hole)

SCREEN-PERFORATED INTERVALS: From 15 ft. to 25 ft. From ft. to ft. From ft. to ft.

GRAVEL PACK INTERVALS: From 13 ft. to 25 ft. From ft. to ft. From ft. to ft.

9 GROUT MATERIAL: ☐ Neat cement ☐ Cement grout ☒ Bentonite ☐ Other 0-1 Concrete

Grout Intervals: From 1 ft. to 13 ft. From ft. to ft. From ft. to ft.

Nearest source of possible contamination:

- ☐ Septic Tank ☐ Lateral Lines ☐ Pit Privy ☐ Livestock Pens ☐ Insecticide Storage
☐ Sewer Lines ☐ Cess Pool ☐ Sewage Lagoon ☒ Fuel Storage ☐ Abandoned Water Well
☐ Watertight Sewer Lines ☐ Seepage Pit ☐ Feedyard ☐ Fertilizer Storage ☐ Oil Well/Gas Well
☐ Other (Specify)

Direction from well? EAST Distance from well? 75 ft.

10 FROM TO LITHOLOGIC LOG FROM TO LITHO. LOG (cont.) or PLUGGING INTERVALS

0 1 Topsoil, silty clay loam

1 18 Silty clay

18 22 Sandy clay

22 25 Silty clay

11 CONTRACTOR'S OR LANDOWNER'S CERTIFICATION: This water well was ☒ constructed, ☐ reconstructed, or ☐ plugged under my jurisdiction and was completed on (mo-day-year) 12/8/21 and this record is true to the best of my knowledge and belief. Kansas Water Well Contractor's License No. 585. This Water Well Record was completed on (mo-day-year) 1/7/21 under the business name of Associated Environmental, Inc. Signature


Mail 1 white copy along with a fee of \$5.00 for each constructed well to: Kansas Department of Health and Environment, Bureau of Water, GWTS Section, 1000 SW Jackson St., Suite 420, Topeka, Kansas 66612-1367. Mail one to Water Well Owner and retain one for your records. Telephone 785-296-5524.

Visit us at <http://www.kdheks.gov/waterwell/index.html>

KSA 82a-1212

Revised 7/10/2015

Notes: Clifton Cardlock U5-101-15172
Clifton, KS 66937

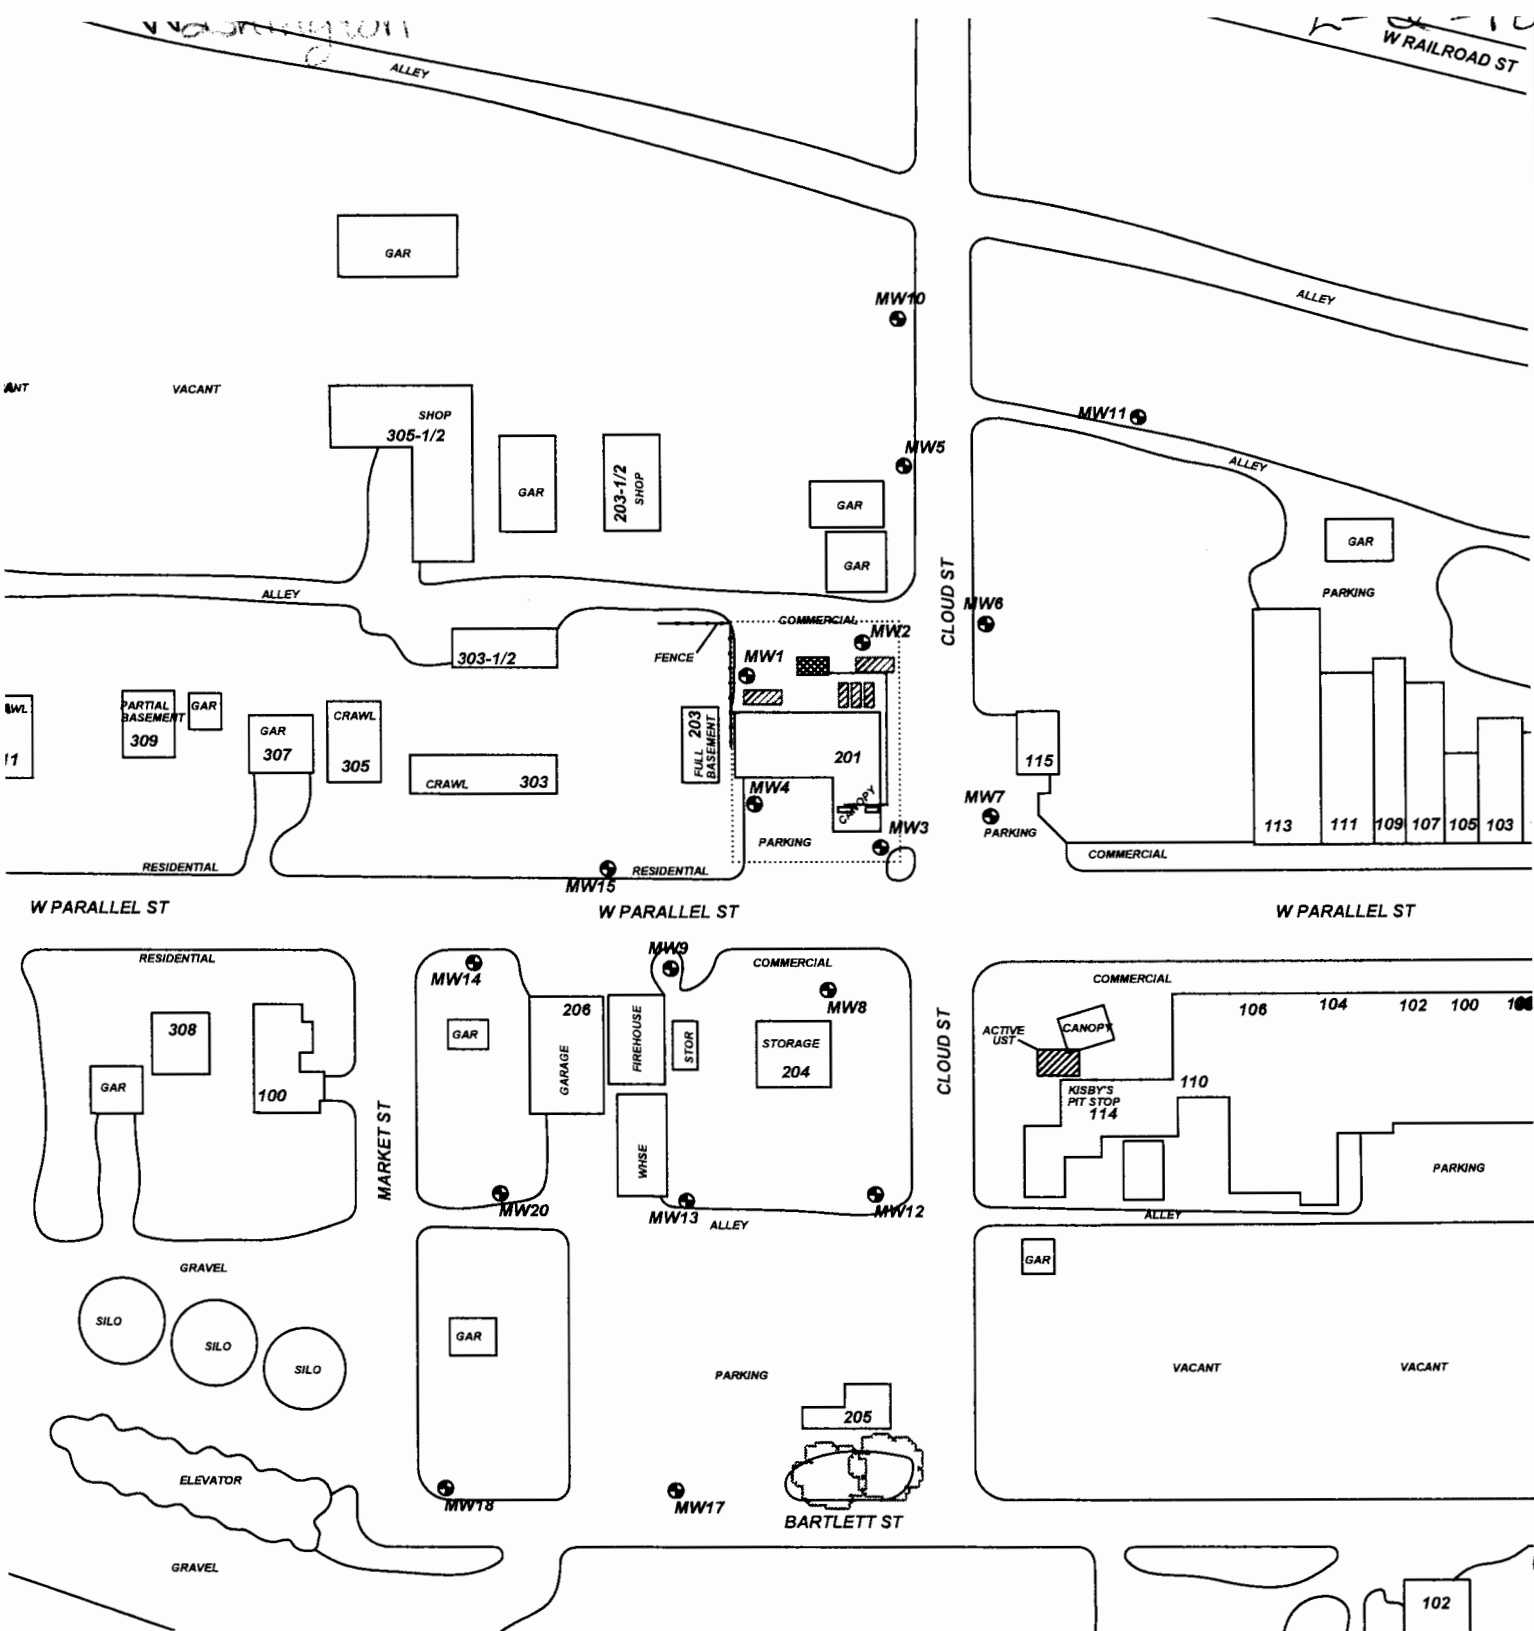

PROJECT: **CLIFTON CARDLOCK**

ADDRESS: **201 W. PARALLEL ST.**

LOCATION: **CLIFTON, KS**

DRAWN BY: **C. ROE** DATE: **1/15/20**

REVISED BY: **B. STALNAKER** DATE: **1/6/12**

AEI JOB #: **TF521** KDHE JOB #: **U5-101-15172**

TITLE:

ASSOCIATED ENVIRONMENTAL INC.

LEGEND:

- = FORMER USTS
- = ACTIVE AST, FUEL LINES AND PUMP ISLANDS
- = MONITORING WELL
- = SUBJECT PROPERTY

RECEIVED

MAR 2 2022

BUREAU OF WATER

SCALE: **1" = 100'**

NOTES: