


LOCATION OF WATER WELL: Fraction NW 1/4 NE 1/4 NE 1/4 Section Number 35 Township Number T 6 S Range Number R 1E E/W  
 County: Clay

Distance and direction from nearest town or city street address of well if located within city?  
 5 1/2 mile South of Clifton

WATER WELL OWNER: Robert Taylor, Jr.  
 RR#, St. Address, Box # : Board of Agriculture, Division of Water Resources  
 City, State, ZIP Code : Clifton, KS 66937 Application Number:

LOCATE WELL'S LOCATION WITH AN "X" IN SECTION BOX:

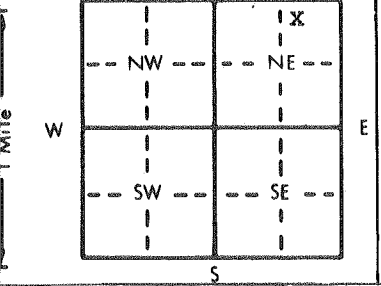

DEPTH OF COMPLETED WELL: 60' ft. ELEVATION: ...  
 Depth(s) Groundwater Encountered 1. 40' ft. 2. ... ft. 3. ... ft.  
 WELL'S STATIC WATER LEVEL: 38' ft. below land surface measured on mo/day/yr 7-22-88 88 ...  
 Pump test data: Well water was 58' ft. after 3/4 hours pumping 8 gpm  
 Est. Yield 8 gpm: Well water was ... ft. after ... hours pumping ... gpm  
 Bore Hole Diameter: 8" in. to 60' ft., and ... in. to ... ft.  
 WELL WATER TO BE USED AS:  
 1 Domestic 3 Feedlot 6 Oil field water supply 9 Dewatering 12 Other (Specify below)  
 2 Irrigation 4 Industrial 7 Lawn and garden only 10 Observation well  
 Was a chemical/bacteriological sample submitted to Department? Yes ... No  X ...; If yes, mo/day/yr sample was submitted  
 Water Well Disinfected? Yes  X No

TYPE OF BLANK CASING USED:  
 1 Steel 3 RMP (SR) 5 Wrought iron 8 Concrete tile CASING JOINTS: Glued  X ... Clamped ...  
 2 PVC 4 ABS 6 Asbestos-Cement 9 Other (specify below) Welded ...  
 7 Fiberglass Threaded ...  
 Blank casing diameter 5" in. to 50 ft., Dia ... in. to ... ft., Dia ... in. to ... ft.  
 Casing height above land surface 12" in., weight 3 lbs./ft. Wall thickness or gauge No. 258

TYPE OF SCREEN OR PERFORATION MATERIAL:  
 1 Steel 3 Stainless steel 5 Fiberglass 7 PVC 10 Asbestos-cement  
 2 Brass 4 Galvanized steel 6 Concrete tile 8 RMP (SR) 11 Other (specify) ...  
 12 None used (open hole)

SCREEN OR PERFORATION OPENINGS ARE:  
 1 Continuous slot 3 Mill slot 5 Gauzed wrapped 8 Saw cut 11 None (open hole)  
 2 Louvered shutter 4 Key punched 6 Wire wrapped 9 Drilled holes  
 7 Torch cut 10 Other (specify) ...

SCREEN-PERFORATED INTERVALS: From 50 ft. to 60 ft., From ... ft. to ... ft.  
 GRAVEL PACK INTERVALS: From 20 ft. to 60 ft., From ... ft. to ... ft.

GROUT MATERIAL: 1 Neat cement 2 Cement grout 3 Bentonite 4 Other ...  
 Grout Intervals: From 0 ft. to 20 ft., From ... ft. to ... ft., From ... ft. to ... ft.

What is the nearest source of possible contamination: NONE  
 1 Septic tank 4 Lateral lines 7 Pit privy 10 Livestock pens 14 Abandoned water well  
 2 Sewer lines 5 Cess pool 8 Sewage lagoon 11 Fuel storage 15 Oil well/Gas well  
 3 Watertight sewer lines 6 Seepage pit 9 Feedyard 12 Fertilizer storage 16 Other (specify below)  
 13 Insecticide storage

Direction from well? How many feet?

FROM	TO	LITHOLOGIC LOG	FROM	TO	LITHOLOGIC LOG
0	30	Clay			
30	30	Sandy Clay			
40	50	Clay & Rocks			
50	60	Sandrock			
	60	Stopped in clay			

7] CONTRACTOR'S OR LANDOWNER'S CERTIFICATION: This water well was (1) constructed, (2) reconstructed, or (3) plugged under my jurisdiction and was completed on (mo/day/year) 7-22-88 and this record is true to the best of my knowledge and belief. Kansas Water Well Contractor's License No. 361 This Water Well Record was completed on (mo/day/yr) 6-30-89 under the business name of Cox-Beswick Irrigation Service, Inc. by (signature) *Amie Beswick*