

USE TYPEWRITER OR BALL POINT PEN-PRESS FIRMLY, PRINT CLEARLY.

T R EW sec 1/4 1/4 1/4 No.


WATER WELL RECORD
KSA 82a-1201-1215

Kansas State Dept. Of Health
(Water Well Contractors)
Forbes-Bldg. 740
Topeka, Kansas 66620

CSE 1/4

1 Location of well: County CLAY Township name MULBERRY Fraction E 1/4 S 1/4 Section number 35 Town number T 6 S Range number R 1 E

Distance and direction from nearest town or city: 4 1/2 SOUTH 3 Owner of well: BOB RUNDLE
Street address of well location if in city: CLIFTON Address: RR # 3 CLIFTON, KANSAS

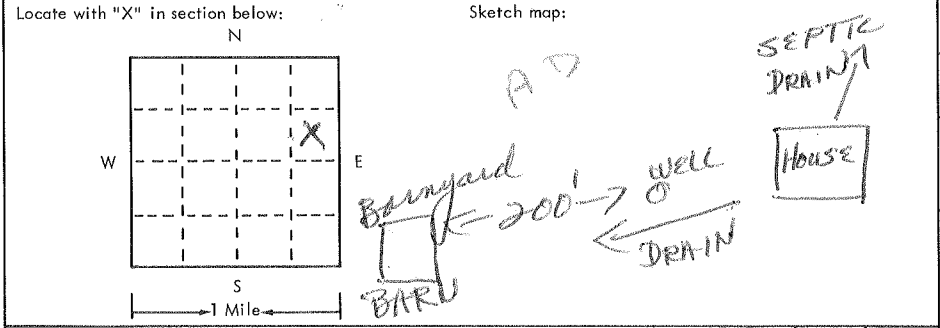

4 Well depth: 68 ft. Date of completion 7/10/75
Well diameter 8 in.

5 Cable tool Rotary Driven Dug
 Hollow rod Jetted Bored Reverse rotary

6 Use: Domestic Public supply Industry
 Irrigation Air conditioning Commercial
 Test well

7 Casing: Material PVC Height above below
Threaded Welded Surface 12 in.
Diam. _____ Weight 3 lbs./ft.
5 in. to 68 ft. depth Drive shoe? Yes No
_____ in. to _____ ft. depth

2	Type and color of material	From	To
	<u>Black topsoil</u>	<u>1</u>	<u>5</u>
	<u>Brown sandy clay</u>	<u>5</u>	<u>17</u>
	<u>Brown sandy</u>	<u>17</u>	<u>31</u>
	<u>Sand + fine gravel</u>	<u>31</u>	<u>65</u>
	<u>Sandrock</u>	<u>65</u>	<u>68</u>
	<u>Blue Shale Stop</u>	<u>68</u>	

8 Screen: Manufacturer YESS + LOWELL
Type PVC Dia. 5"
Slot/gauze 1/4" Length 20'
Set between 48 ft. and 40 ft.

Fittings:
Gravel pack Yes No Size range of material 4" x 1/4"

9 Static water level:
30 ft. below land surface Date 7/10/75

10 Pumping level below land surfaces:
NA ft. after NA hrs. pumping NA g.p.m.
NA ft. after NA hrs. pumping NA g.p.m.
Estimated maximum yield 50 g.p.m.

11 Water sample submitted:
 Yes No Date _____

12 Well head completion:
 Pitless adapter Inches above grade

13 Well grouted? Yes No
 Neat cement Bentonite _____
Depth: From 3 ft. to 13 ft.

14 Nearest source of possible contamination:
ft. 200 Direction NE Type BARNYARD
Well disinfected upon completion? Yes No

15 Pump: Not installed
Manufacturer's name _____
Model number _____ HP _____ Volts _____
Length of drop pipe _____ ft. capacity _____ g.m.p.
Type:
 Submersible Turbine
 Jet Reciprocating
 Centrifugal Other

16 Remarks: elevation
ON SIDE OF HILL ON
ROUGH FARMSTEAD

Topography:
 Hill
 Slope
 Upland
 Valley

17 Water well contractor's certification:
This well was drilled under my jurisdiction and this report is true to the best of my knowledge and belief.

GEO LOX + SONS INC 258
Business name License No. _____
Address: CLIFTON, KANSAS
Signed: Carol Vest Date 10/21/75
Authorized representative