

CORRECTION(S) TO WATER WELL RECORD (WWC-5)
(to rectify lacking or incorrect information)

County: Pottawatomie

Location listed as:

Section-Township-Range: 5-7S-10

Fraction ($\frac{1}{4}$ $\frac{1}{4}$ $\frac{1}{4}$): E $\frac{1}{2}$ of NE $\frac{1}{4}$

Location changed to:

32-6S-10E

E2 NE SE

Other changes: Initial statements: _____

Changed to: _____

Comments: _____

verification method: County ownership map, aerial photos on KGS website,
and Westmoreland NE 1:24,000 topo. map.

initials: DRL date: 9/13/2005

submitted by: Kansas Geological Survey, Data Resources Library, 1930 Constant Ave., Lawrence, KS 66047-3726
to: Kansas Dept of Health & Environment, Bureau of Water, 1000 SW Jackson, Suite 420, Topeka, KS 66612-1367.

20

USE TYPEWRITER OR BALL POINT PEN-PRESS FIRMLY, PRINT CLEARLY.

T	R	EW	sec 1/4	1/4	1/4	No.
---	---	----	---------	-----	-----	-----


WATER WELL RECORD
KSA 82a-1201-1215

Kansas State Dept. Of Health
(Water Well Contractors)
Forbes-Bldg. 740
Topeka, Kansas 66620

SESESE 32

1 Location of well: County Pott. Township name Sherman Fraction E. 1/2 of NE 1/4 Section number 5 Town number 7.5 Range number 10

Distance and direction from nearest town or city:
Street address of well location if in city:
3 Owner of well: Loring Kufahl
Address:

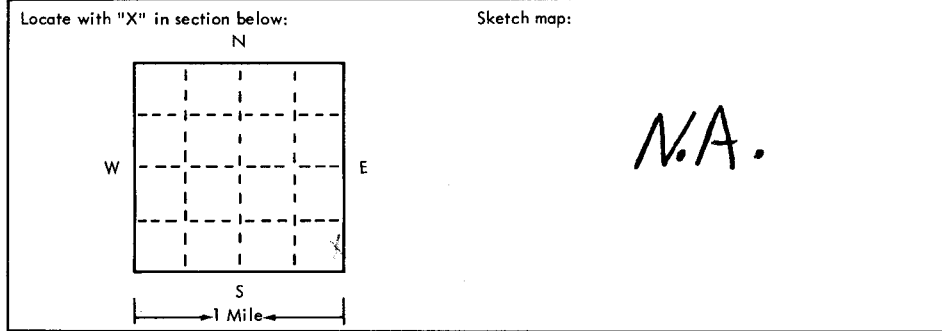

4 Well depth: 77' ft. Date of completion 4/24/75
Well diameter 7 in.

5 Cable tool Rotary Driven Dug
 Hollow rod Jetted Bored Reverse rotary

6 Use: Domestic Public supply Industry
 Irrigation Air conditioning Commercial
 Test well

7 Casing: Material Steel Height: above/below
Threading Welded Surface 24 in.
Diam. 7 in. to 32 Steel Weight 24 lbs./ft. 1
32 in. to 77 ft. depth Drive shoe? Yes No
77 in. to 77 ft. depth PVC

2

Type and color of material	From	To
<u>Top Soil and Brown Clay</u>	<u>0</u>	<u>10</u>
<u>Creek Gravel</u>	<u>10</u>	<u>32</u>
<u>Blue Shale</u>	<u>32</u>	<u>77</u>

8 Screen:
Manufacturer
Type Steel Dia. 7"
Slot/gauze 1/2" Length 10' Perf.
Set between 4 1/2 ft. and 32 ft.
Fittings:
Gravel pack Yes No Size range of material no

9 Static water level:
10 ft. below land surface Date 4/26/75

10 Pumping level below land surfaces:
____ ft. after ____ hrs. pumping ____ g.p.m.
____ ft. after N/A hrs. pumping ____ g.p.m.
Estimated maximum yield 10 g.p.m. Boiler Test

11 Water sample submitted:
 Yes No Date ____

12 Well head completion:
 Pitless adapter 60 inches above grade

13 Well grouted? Yes No
 Neat cement Bentonite Pud. Clay
Depth: From 0 ft. to 10 ft.

14 Nearest source of possible contamination:
ft. 150 Direction 10, E Type Feed Lot
Well disinfected upon completion? Yes No

15 Pump: Not installed
Manufacturer's name _____ HP _____ Volts _____
Length of drop pipe _____ ft. capacity _____ g.m.p.
Type:
 Submersible Turbine
 Jet Reciprocating
 Centrifugal Other

16 Remarks: elevation
1450
Topography: U
 Hill
 Slope
 Upland
 Valley

17 Water well contractor's certification:
This well was drilled under my jurisdiction and this report is true to the best of my knowledge and belief.
Harpers Drlg. Service
Business name Blue Rapids, Ks. License No. 176
Address 606 N. Main
Signed L. Kufahl Date 4-26-75
Authorized representative