

WATER WELL PLUGGING RECORD Form WWC-5P

KSA 82a-1212

ID NO.

MW5

1 LOCATION OF WATER WELL: Fraction Section Number Township Number Range Number
 County: Pottawatomie SW ¼ NW¼ SE ¼ NE ¼ 29 T 6 S 10 ☒ E ☐ W

Street/Rural Address of Well Location; if unknown, distance & direction from nearest town or intersection: If at owner's address, check here ☐ Main Street & Center Street
 Wheaton, Kansas

Global Positioning Systems (GPS) information:

Latitude: 39.50247 (in decimal degrees)

Longitude: 96.31815 (in decimal degrees)

Elevation: 1508.48 Ground

Horizontal Datum: ☐ WGS84, ☒ NAD83, ☐ NAD27


Collection Method:

2 WATER WELL OWNER: Pottawatomie County
 RR#, St. Address, Box #: PO Box 187
 City, State ZIP Code: Westmoreland, KS 66549

☐ GPS unit (Make/Model: _____)
☐ Digital Map/Photo, ☐ Topographic Map, ☒ Land Survey

Est. Accuracy: ☒ < 3 m, ☐ 3-5 m, ☐ 5-15 m, ☐ > 15 m

3 MARK WELL'S LOCATION WITH AN "X" IN SECTION BOX:

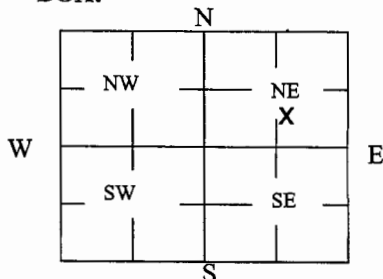

4 DEPTH OF WELL 25.07 ft.

WELL'S STATIC WATER LEVEL Dry _____ ft

WELL WAS USED AS:

☐ Domestic ☐ Public Water Supply ☐ Dewatering
☐ Irrigation ☐ Oil Field Water Supply ☒ Monitoring
☐ Feedlot ☐ Domestic (Lawn & Garden) ☐ Injection Well
☐ Industrial ☐ Air Conditioning ☐ Other _____

Was a chemical/bacteriological sample submitted to Department? Yes ☐ No ☒

5 TYPE OF BLANK CASING USED:

☐ Steel ☐ RMP (SR) ☐ Wrought ☐ Fiberglass ☐ Other (Specify below)
☒ PVC ☐ ABS ☐ Asbestos-Cement ☐ Concrete Tile

Blank casing diameter 2 in. Was casing pulled? Yes ☒ No ☐ If yes, how much 3 Ft

Casing height above or below land surface 36 in.

6 GROUT PLUG MATERIAL: ☐ Neat cement ☐ Cement grout ☒ Bentonite ☐ Other _____

Grout Plug Intervals: From 3 ft. to 25.07 ft., From _____ ft. to _____ ft., From _____ ft. to _____ ft.

What is the nearest source of possible contamination:

☐ Septic tank ☐ Seepage pit ☐ Fuel storage ☒ Other (specify below)
☐ Sewer lines ☐ Pit privy ☐ Fertilizer storage Contaminated Site U4-075-14975
☐ Watertight sewer lines ☐ Sewage lagoon ☐ Insecticide storage
☐ Lateral lines ☐ Feedyard ☐ Abandoned water well Direction from well? Northeast
☐ Cess pool ☐ Livestock pens ☐ Oil well/Gas well How many feet? 50

FROM	TO	PLUGGING MATERIALS	FROM	TO	PLUGGING MATERIALS
0	3	Compacted Silt/Clay			
3	25.07	Hydrated Bentonite chips			
					U4-075-14975


7 CONTRACTOR'S OR LANDOWNER'S CERTIFICATION: This water well was plugged under my jurisdiction and was completed on (mo/day/year) 12/20/18 and this record is true to the best of my knowledge and belief. Kansas Water Well Contractor's License No. 585. This Water Well Record was completed on (mo/day/year) 1/10/19 under the business name of Associated Environmental, Inc. by (signature) *Bradley Johnson*

Send one white copy to Kansas Department of Health & Environment, Geology Section, 1000 SW Jackson Street, Ste. 420, Topeka, KS 66612-1367. Send one copy to WATER WELL OWNER and retain one for your records.

Visit us at <http://www.kdheks.gov/waterwell/index.html> Telephone 785-296-5524.

KSA82a-1212

Revised 1/20/2015

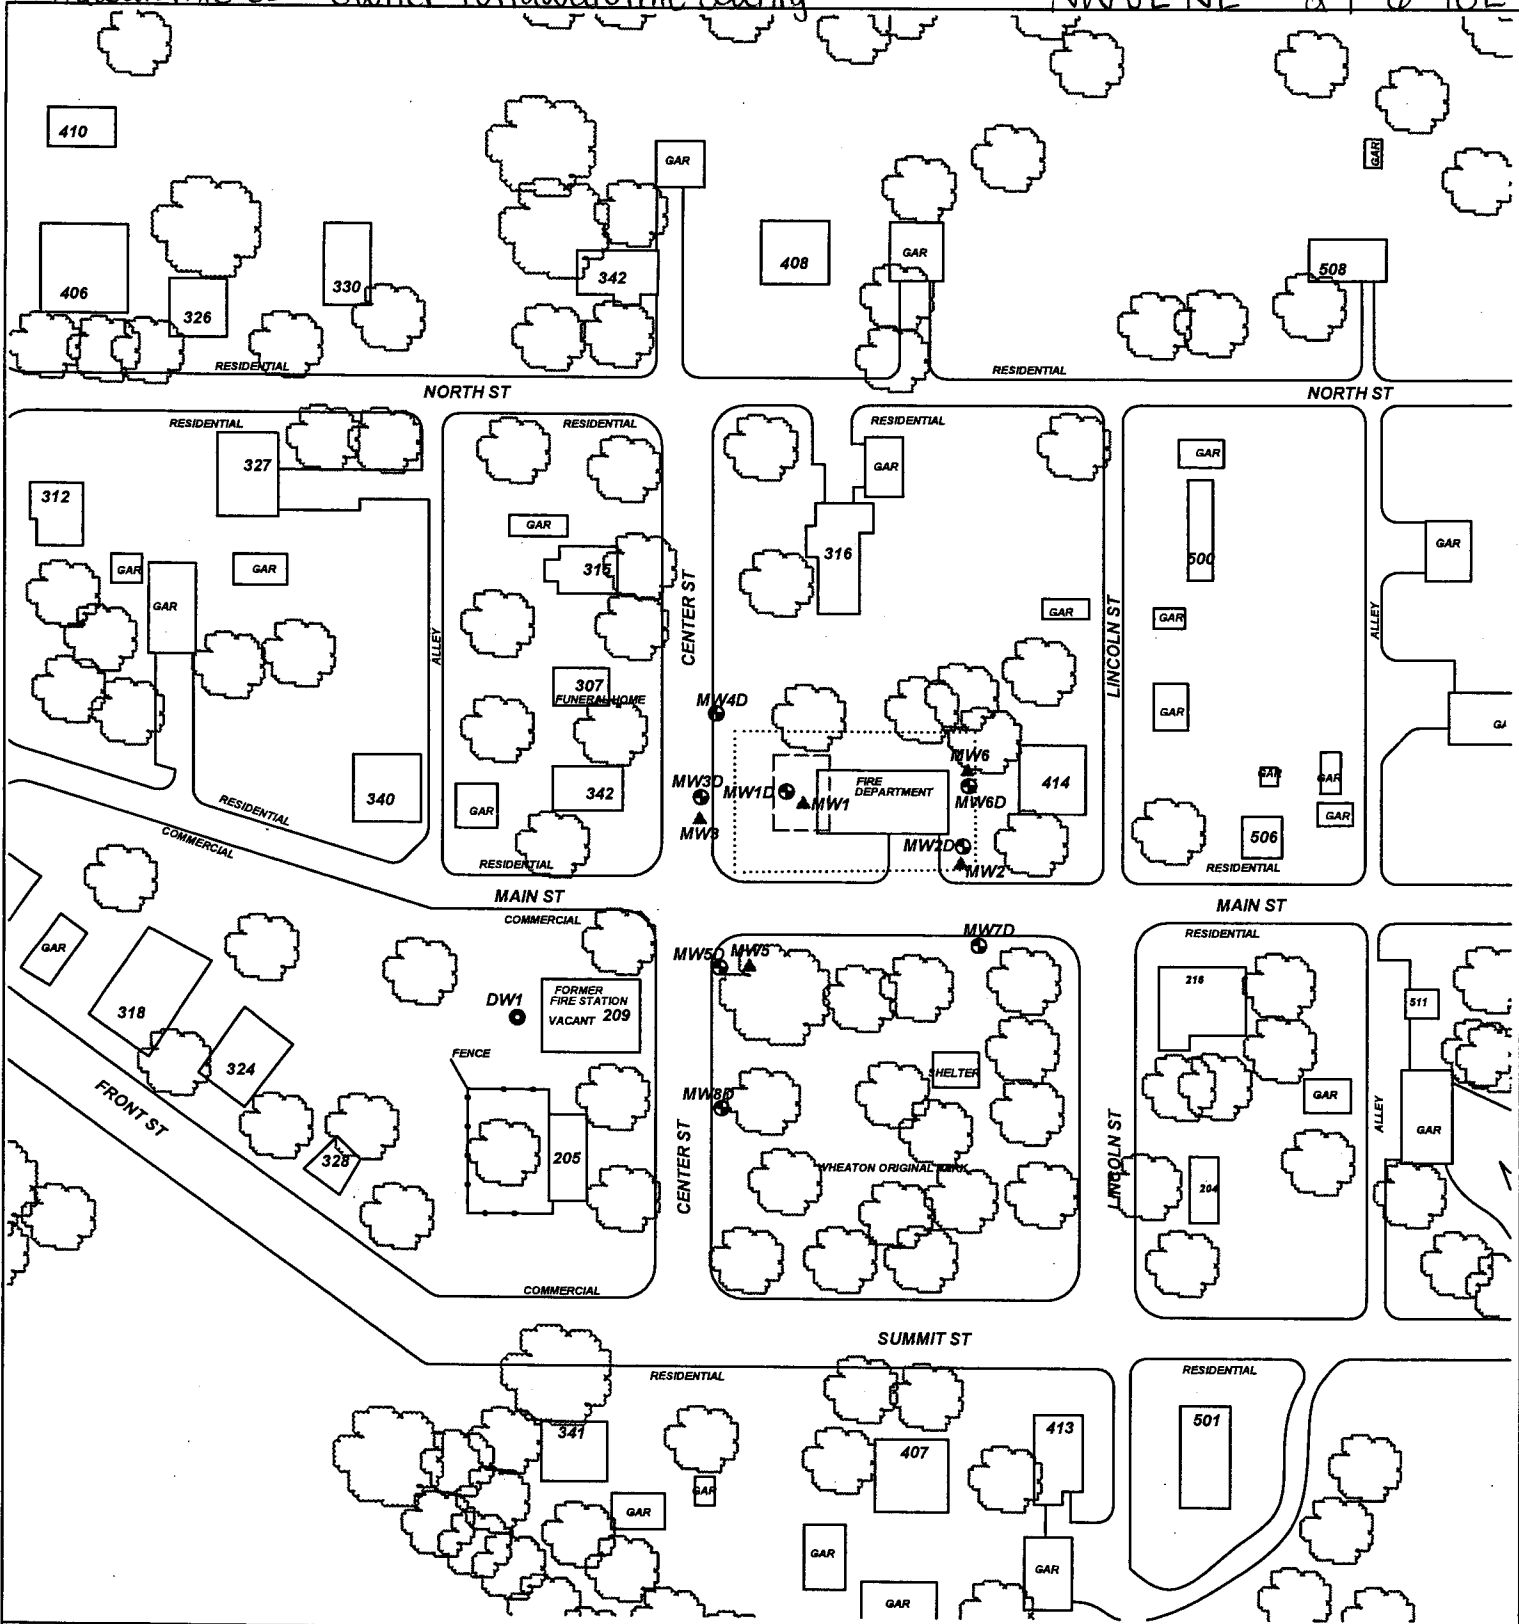

PROJECT: **NEW WHEATON FIRE STATION**

ADDRESS: **MAIN ST & CENTER ST**

LOCATION: **WHEATON, KS**

DRAWN BY: **B. STALNAKER** DATE: **2/6/18**

REVISED BY: **B. STALNAKER** DATE: **1/8/19**


AEI JOB # **TM226** KQHE JOB # **U4-075-14975**

TITLE:

ASSOCIATED ENVIRONMENTAL INC.

LEGEND:

- = FORMER UST BASIN/EXCAVATION
- = MONITORING WELL
- = PRIVATE WELL
- = PLUGGED/DESTROYED WELL
- = SUBJECT PROPERTY

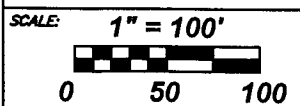

NOTES:

No basements observed within 500'.