

**WATER WELL RECORD Form WWC-5**

Original Record  Correction  Change in Well Use

Division of Water Resources App. No.

Well ID MW8D

<b>1 LOCATION OF WATER WELL:</b> County: <b>POTTAWATOMIE</b>	Fraction <b>NW 1/4 SW 1/4 SE 1/4 NE 1/4</b>	Section Number <b>29</b>	Township Number <b>T 6 S</b>	Range Number <b>R 10 <input checked="" type="checkbox"/> E <input type="checkbox"/> W</b>
---	--	-----------------------------	---------------------------------	--

<b>2 WELL OWNER:</b> Last Name: <b>First:</b> Business: <b>KDHE-BER</b> Address: <b>1000 SW JACKSON</b> Address: City: <b>TOPEKA</b> State: <b>KS</b> ZIP: <b>66612</b>	Street or Rural Address where well is located (if unknown, distance and direction from nearest town or intersection): If at owner's address, check here: <input type="checkbox"/> <b>CENTER AND MAIN, WHEATON KS</b>
---	---

**3 LOCATE WELL WITH "X" IN SECTION BOX:**  
N

NW	NE
SW	SE

S

-----1 mile-----

**4 DEPTH OF COMPLETED WELL:** ..... **75** ..... ft.  
 Depth(s) Groundwater Encountered: 1) ..... ft.  
 2) ..... ft. 3) ..... ft., or 4)  Dry Well  
**WELL'S STATIC WATER LEVEL:** ..... **57.08** ..... ft.  
 below land surface, measured on (mo-day-yr) ..... **11/21/18** .....  
 above land surface, measured on (mo-day-yr) .....  
 Pump test data: Well water was ..... ft.  
 after ..... hours pumping ..... gpm  
 Well water was ..... ft.  
 after ..... hours pumping ..... gpm  
 Estimated Yield: ..... gpm  
 Bore Hole Diameter: **6.5** in. to **75** ft. and  
 ..... in. to ..... ft.

**5 Latitude:** ..... **39.50223** ..... (decimal degrees)  
**Longitude:** ..... **96.31815** ..... (decimal degrees)  
**Horizontal Datum:**  WGS 84  NAD 83  NAD 27  
**Source for Latitude/Longitude:**  
 GPS (unit make/model: .....)  
 (WAAS enabled?  Yes  No)  
 Land Survey  Topographic Map  
 Online Mapper: .....

**6 Elevation:** **1510.38** ..... ft.  Ground Level  TOC  
**Source:**  Land Survey  GPS  Topographic Map  
 Other .....

**7 WELL WATER TO BE USED AS:**

1. <input type="checkbox"/> Domestic: <input type="checkbox"/> Household <input type="checkbox"/> Lawn & Garden <input type="checkbox"/> Livestock	5. <input type="checkbox"/> Public Water Supply: well ID .....	10. <input type="checkbox"/> Oil Field Water Supply: lease .....
2. <input type="checkbox"/> Irrigation	6. <input type="checkbox"/> Dewatering: how many wells? .....	11. Test Hole: well ID ..... <input type="checkbox"/> Cased <input type="checkbox"/> Uncased <input type="checkbox"/> Geotechnical
3. <input type="checkbox"/> Feedlot	7. <input type="checkbox"/> Aquifer Recharge: well ID .....	12. Geothermal: how many bores? ..... a) Closed Loop <input type="checkbox"/> Horizontal <input type="checkbox"/> Vertical
4. <input type="checkbox"/> Industrial	8. <input checked="" type="checkbox"/> Monitoring: well ID <b>MW8D</b>	b) Open Loop <input type="checkbox"/> Surface Discharge <input type="checkbox"/> Inj. of Water
	9. Environmental Remediation: well ID ..... <input type="checkbox"/> Air Sparge <input type="checkbox"/> Soil Vapor Extraction <input type="checkbox"/> Recovery <input type="checkbox"/> Injection	13. <input type="checkbox"/> Other (specify): .....

**Was a chemical/bacteriological sample submitted to KDHE?**  Yes  No If yes, date sample was submitted: .....

Water well disinfected?  Yes  No

**8 TYPE OF CASING USED:**  Steel  PVC  Other ..... **CASING JOINTS:**  Glued  Clamped  Welded  Threaded  
 Casing diameter ..... **2** ..... in. to ..... **75** ..... ft., Diameter ..... in. to ..... ft., Diameter ..... in. to ..... ft.  
 Casing height above land surface ..... in. Weight ..... lbs./ft. Wall thickness or gauge No. ....

**TYPE OF SCREEN OR PERFORATION MATERIAL:**  
 Steel  Stainless Steel  Fiberglass  PVC  Other (Specify) .....  
 Brass  Galvanized Steel  Concrete tile  None used (open hole)

**SCREEN OR PERFORATION OPENINGS ARE:**  
 Continuous Slot  Mill Slot  Gauze Wrapped  Torch Cut  Drilled Holes  Other (Specify) .....  
 Louvered Shutter  Key Punched  Wire Wrapped  Saw Cut  None (Open Hole)

**SCREEN-PERFORATED INTERVALS:** From **55** ..... ft. to **75** ..... ft., From ..... ft. to ..... ft., From ..... ft. to ..... ft.  
**GRAVEL PACK INTERVALS:** From **53** ..... ft. to **75** ..... ft., From ..... ft. to ..... ft., From ..... ft. to ..... ft.

**9 GROUT MATERIAL:**  Neat cement  Cement grout  Bentonite  Other **Concrete Surface Completion 0 - 1** .....  
 Grout Intervals: From **0** ..... ft. to **1** ..... ft., From **1** ..... ft. to **53** ..... ft., From ..... ft. to ..... ft.

**Nearest source of possible contamination:**  
 Septic Tank  Lateral Lines  Pit Privy  Livestock Pens  Insecticide Storage  
 Sewer Lines  Cess Pool  Sewage Lagoon  Fuel Storage  Abandoned Water Well  
 Watertight Sewer Lines  Seepage Pit  Feedyard  Fertilizer Storage  Oil Well/Gas Well  
 Other (Specify) .....

Direction from well? ..... Distance from well? ..... ft.

10 FROM	TO	LITHOLOGIC LOG	FROM	TO	LITHO. LOG (cont.) or PLUGGING INTERVALS
0	1	TOPSOIL			
1	40	Silty Clay (CL), brown			
40	62	LIMESTONE			
62	75	REDDISH SHALE			

Notes: **KDHE #**  
**U4-075-14975**

**11 CONTRACTOR'S OR LANDOWNER'S CERTIFICATION:** This water well was  constructed,  reconstructed, or  plugged under my jurisdiction and was completed on (mo-day-year) **11/20/18** ..... and this record is true to the best of my knowledge and belief. Kansas Water Well Contractor's License No. **585** ..... This Water Well Record was completed on (mo-day-year) **12/14/18** ..... under the business name of **ASSOCIATED ENVIRONMENTAL INC.** Signature .....




SE NW SE NE  
NW NW SE NE

RESIDENTIAL

NORTH ST

RESIDENTIAL

RESIDENTIAL

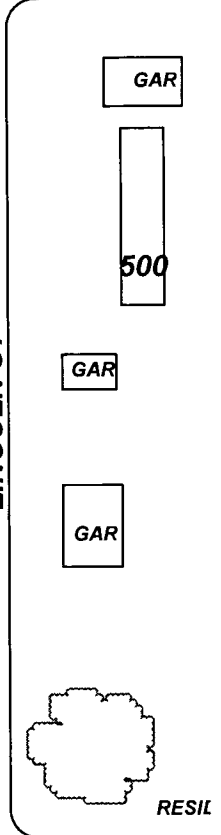
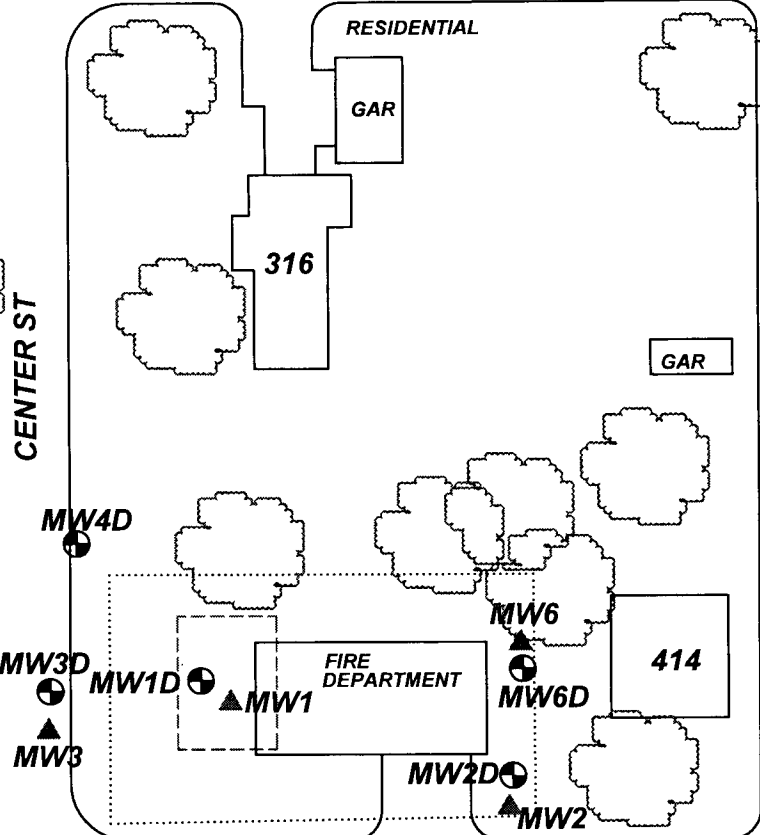
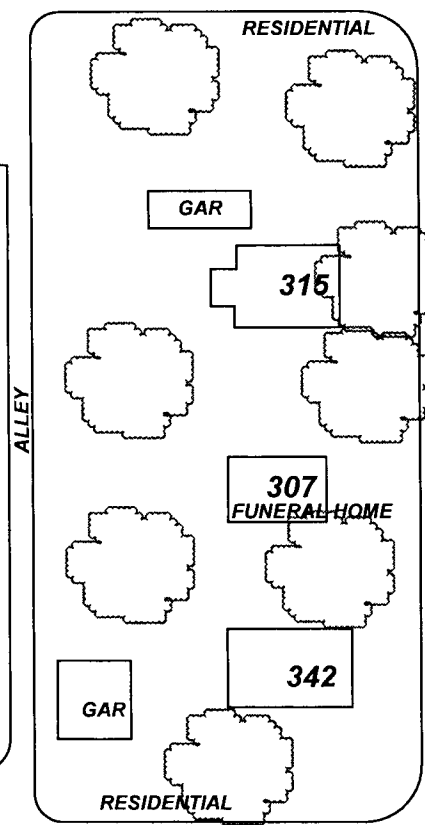


MAIN ST

COMMERCIAL

MA

RESIDEN

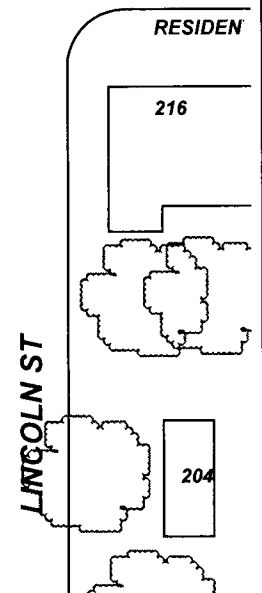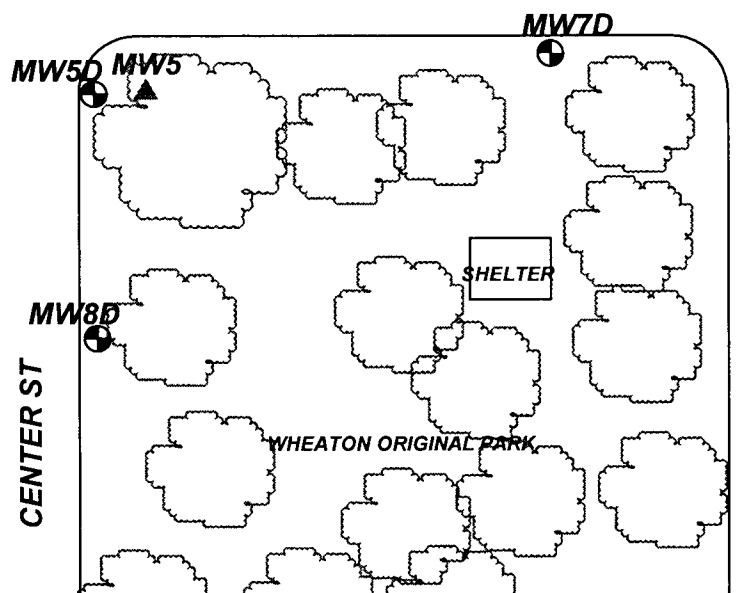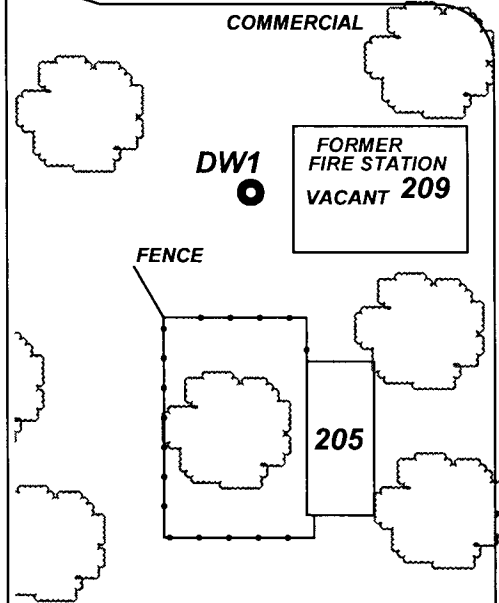

PROJECT: **NEW WHEATON FIRE STATION**

TITLE:


ADDRESS: **MAIN ST & CENTER ST**

LOCATION: **WHEATON, KS**

DRAWN BY: **B. STALNAKER** DATE: **2/6/18**

REVISED BY: **B. STALNAKER** DATE: **1/8/19**


AET JOB # **TM226** KDHE JOB # **U4-075-14975**

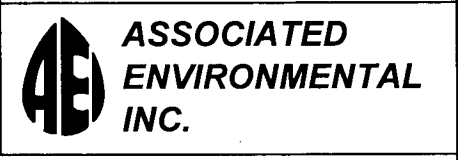

- LEGEND:
- = FORMER UST BASIN/EXCAVATION
  - = MONITORING WELL
  - = PRIVATE WELL
  - = PLUGGED/DESTROYED WELL



..... = SUBJECT PROPERTY

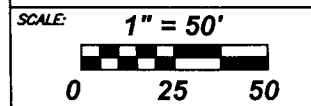

NOTES:  
No basements observed within 500'.