

rev seq

WATER WELL RECORD Form WWC-5

Division of Water Resources App. No.

Well ID

MW2D

Original Record Correction Change in Well Use

1 LOCATION OF WATER WELL: County: POTTAWATOMIE Fraction SE 1/4 NW 1/4 SE 1/4 NE 1/4 Section Number 29 Township Number T 6 S Range Number R 10 E W

2 WELL OWNER: Last Name: KDHE-BER Business: KDHE-BER Address: 1000 SW JACKSON City: TOPEKA State: KS ZIP: 66612 Street or Rural Address where well is located (if unknown, distance and direction from nearest town or intersection): CENTER AND MAIN, WHEATON KS

3 LOCATE WELL WITH 'X' IN SECTION BOX: [Diagram] 4 DEPTH OF COMPLETED WELL: 75 ft. 5 Latitude: 39.50273 Longitude: 96.31761 6 Elevation: 1510.46 ft.

7 WELL WATER TO BE USED AS: 1. Domestic: [ ] Household [ ] Lawn & Garden [ ] Livestock 2. Irrigation 3. Feedlot 4. Industrial 5. Public Water Supply: well ID 6. Dewatering: how many wells? 7. Aquifer Recharge: well ID 8. Monitoring: well ID MW2D 9. Environmental Remediation: well ID 10. Oil Field Water Supply: lease 11. Test Hole: well ID 12. Geothermal: how many bores? 13. Other (specify):

Was a chemical/bacteriological sample submitted to KDHE? [ ] Yes [x] No If yes, date sample was submitted: Water well disinfected? [ ] Yes [x] No

8 TYPE OF CASING USED: [ ] Steel [x] PVC [ ] Other CASING JOINTS: [ ] Glued [ ] Clamped [ ] Welded [x] Threaded Casing diameter: 2 in. to 75 ft. TYPE OF SCREEN OR PERFORMANCE MATERIAL: [ ] Steel [ ] Stainless Steel [ ] Fiberglass [x] PVC [ ] Brass [ ] Galvanized Steel [ ] Concrete tile [ ] None used (open hole)

9 GROUT MATERIAL: [ ] Neat cement [ ] Cement grout [x] Bentonite [x] Other Concrete Surface Completion 0 - 1 Grout Intervals: From 0 ft. to 1 ft., From 1 ft. to 53 ft., From 53 ft. to 75 ft., From 75 ft. to ft.

Nearest source of possible contamination: [ ] Septic Tank [ ] Lateral Lines [ ] Pit Privy [ ] Livestock Pens [ ] Insecticide Storage [ ] Sewer Lines [ ] Cess Pool [ ] Sewage Lagoon [x] Fuel Storage [ ] Abandoned Water Well [ ] Watertight Sewer Lines [ ] Seepage Pit [ ] Feedyard [ ] Fertilizer Storage [ ] Oil Well/Gas Well [ ] Other (Specify)

Table with 6 columns: 10 FROM, TO, LITHOLOGIC LOG, FROM, TO, LITHO. LOG (cont.) or PLUGGING INTERVALS. Rows: 0-1 TOPSOIL, 1-40 Silty Clay (CL), brown, 40-62 LIMESTONE, 62-75 REDDISH SHALE

Notes: KDHE # 114-075-14975

11 CONTRACTOR'S OR LANDOWNER'S CERTIFICATION: This water well was [x] constructed, [ ] reconstructed, or [ ] plugged under my jurisdiction and was completed on (mo-day-year) 11/19/18 and this record is true to the best of my knowledge and belief. Kansas Water Well Contractor's License No. 585 This Water Well Record was completed on (mo-day-year) 12/14/18 under the business name of ASSOCIATED ENVIRONMENTAL INC. Signature

Mail 1 white copy along with a fee of \$5.00 for each constructed well to: Kansas Department of Health and Environment, Bureau of Water, GWTS Section, 1000 SW Jackson St., Suite 420, Topeka, Kansas 66612-1367. Mail one to Water Well Owner and retain one for your records. Telephone 785-296-5524. Visit us at http://www.kdheks.gov/waterwell/index.html KSA 82a-1212 Revised 7/10/2015


SE NW SE NE  
NW NW SE NE

RESIDENTIAL


NORTH ST

RESIDENTIAL


RESIDENTIAL

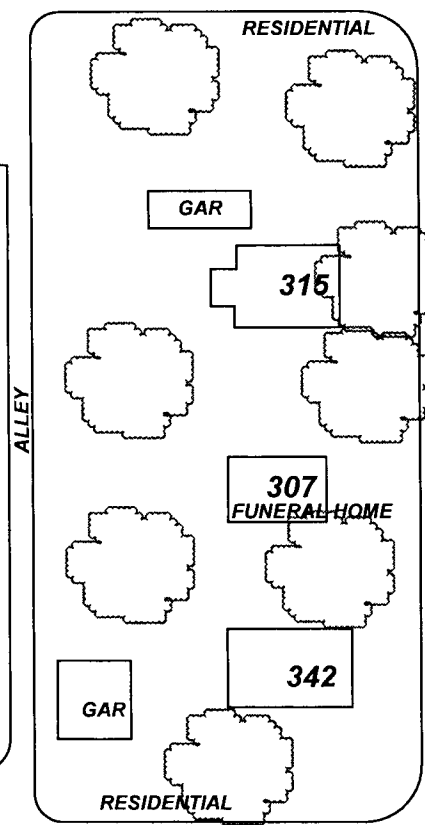

CENTER ST

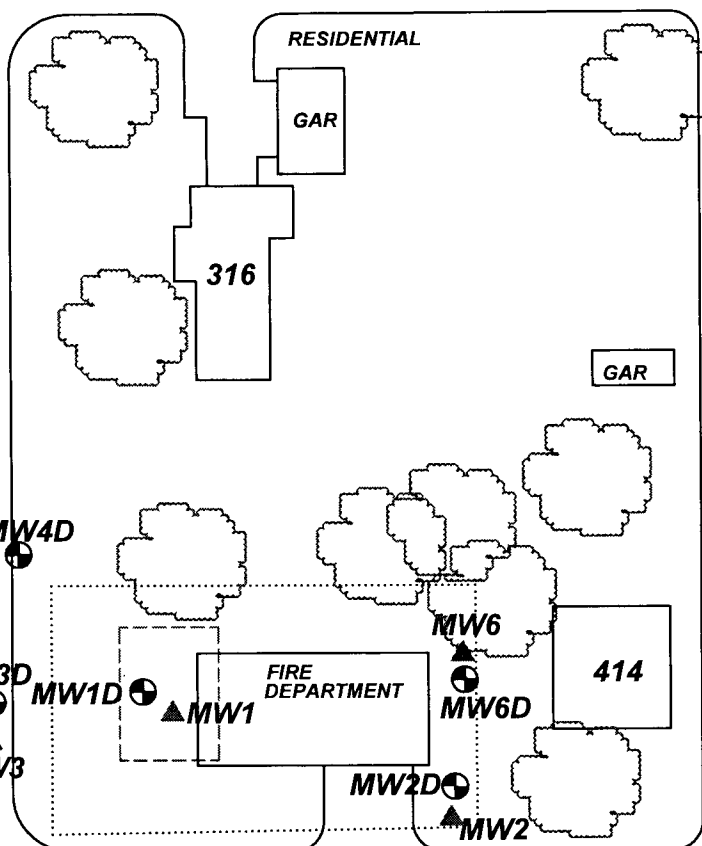

LINCOLN ST


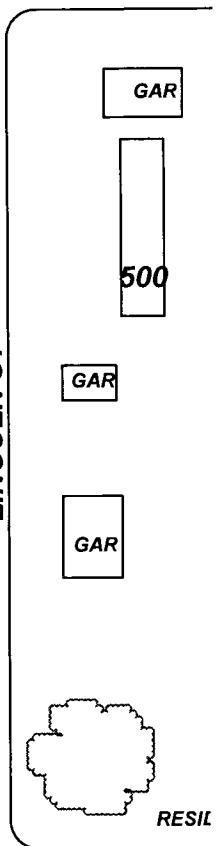


MAIN ST


COMMERCIAL

MA

RESIDEN

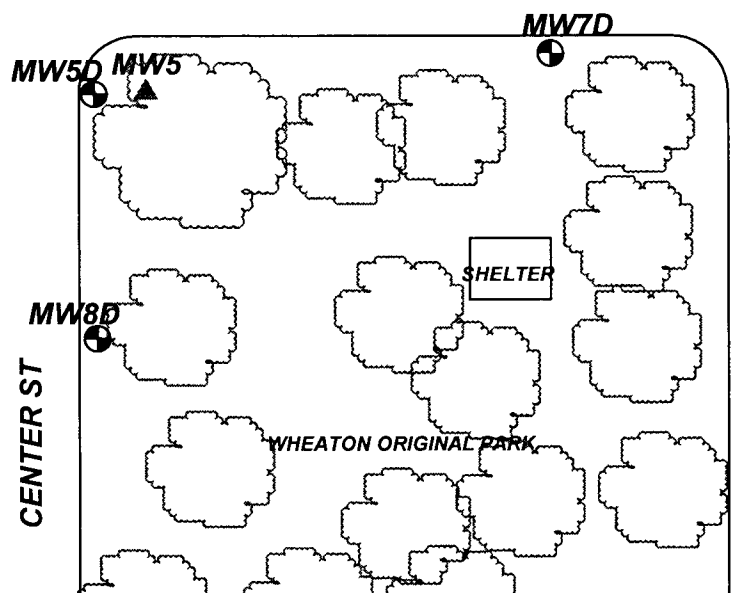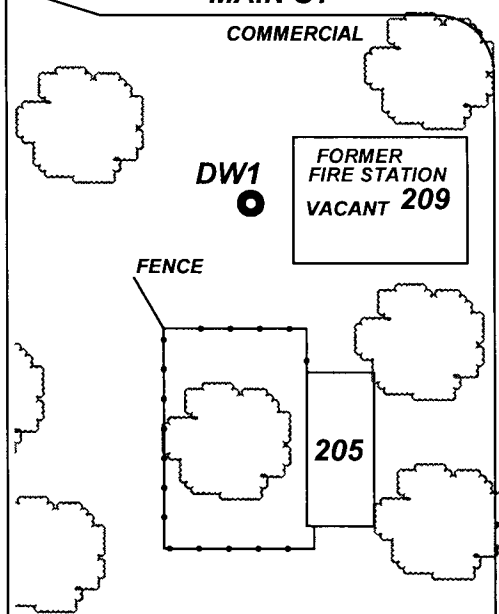

LINCOLN ST

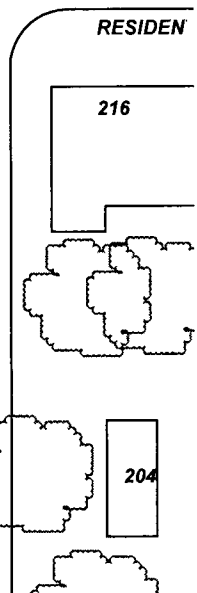

PROJECT: **NEW WHEATON FIRE STATION**

TITLE:


ADDRESS: **MAIN ST & CENTER ST**

LOCATION: **WHEATON, KS**

DRAWN BY: **B. STALNAKER** DATE: **2/6/18**

REVISED BY: **B. STALNAKER** DATE: **1/8/19**

AET JOB # **TM226** KDHE JOB # **U4-075-14975**

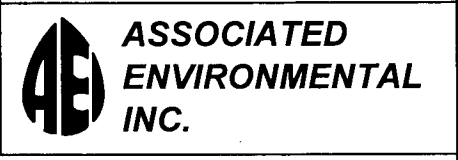


LEGEND:

- = FORMER UST BASIN/EXCAVATION
- = MONITORING WELL
- = PRIVATE WELL
- = PLUGGED/DESTROYED WELL



..... = SUBJECT PROPERTY

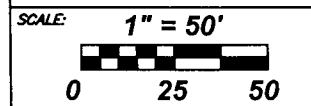

NOTES:  
No basements observed within 500'.