


1 LOCATION OF WATER WELL: Fraction NW NW Section Number 29 Township Number 6 S Range Number 10 E
 County: POTT Distance and direction from nearest town or city street address of well if located within city? 100 North Street in Wbaton

2 WATER WELL OWNER: Jim & Joyce Wheeler Board of Agriculture, Division of Water Resources
 RR#, St. Address, Box #: 100 North ST Application Number:
 City, State, ZIP Code: Wbaton, KS 66551

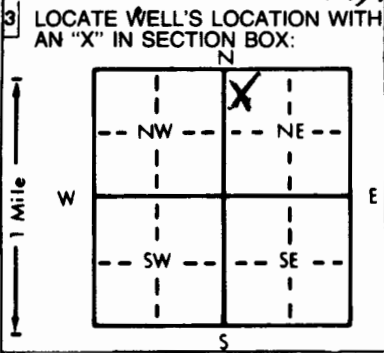

4 DEPTH OF COMPLETED WELL: 130 ft. ELEVATION:
 Depth(s) Groundwater Encountered: 1. 4.9 ft. 2. ft. 3. ft.
 WELL'S STATIC WATER LEVEL: 30 ft. below land surface measured on mo/day/yr
 Pump test data: Well water was ft. after hours pumping gpm
 Est. Yield 2.5 gpm: Well water was ft. after hours pumping gpm
 Bore Hole Diameter: 9 in. to 130 ft., and in. to ft.
 WELL WATER TO BE USED AS:
 1 Domestic 3 Feedlot 6 Oil field water supply 9 Dewatering 12 Other (Specify below)
 2 Irrigation 4 Industrial 7 Lawn and garden only 10 Monitoring well
 Was a chemical/bacteriological sample submitted to Department? Yes No: If yes, mo/day/yr sample was submitted
 Water Well Disinfected? Yes No

5 TYPE OF BLANK CASING USED:
 1 Steel 3 RMP (SR) 5 Wrought iron 8 Concrete tile CASING JOINTS: Glued Clamped
 2 PVC 4 ABS 6 Asbestos-Cement 9 Other (specify below) Welded
 Blank casing diameter: 5 in. to 110 ft., Dia. in. to ft., Dia. in. to ft.
 Casing height above land surface: 2 in., weight SDR 26 lbs./ft. Wall thickness or gauge No.
 TYPE OF SCREEN OR PERFORATION MATERIAL:
 1 Steel 3 Stainless steel 5 Fiberglass 8 RMP (SR) 10 Asbestos-cement
 2 Brass 4 Galvanized steel 6 Concrete tile 9 ABS 12 None used (open hole)
 SCREEN OR PERFORATION OPENINGS ARE:
 1 Continuous slot 3 Mill slot 25/100's 5 Gauzed wrapped 8 Saw cut 11 None (open hole)
 2 Louvered shutter 4 Key punched 6 Wire wrapped 9 Drilled holes
 7 Torch cut 10 Other (specify)
 SCREEN-PERFORATED INTERVALS: From 110 ft. to 130 ft. From ft. to ft.
 GRAVEL PACK INTERVALS: From 25 ft. to 130 ft. From ft. to ft.

6 GROUT MATERIAL: 1 Neat cement 2 Cement grout 3 Bentonite 4 Other
 Grout intervals: From 0 ft. to 25 ft. From ft. to ft.
 What is the nearest source of possible contamination:
 1 Septic tank 4 Lateral lines 7 Pit privy 10 Livestock pens 14 Abandoned water well
 2 Sewer lines 5 Cess pool 8 Sewage lagoon 11 Fuel storage 15 Oil well/Gas well
 3 Watertight sewer lines 6 Seepage pit 9 Feedyard 12 Fertilizer storage 16 Other (specify below)
 13 Insecticide storage
 Direction from well? North How many feet? 160'

| FROM | TO | LITHOLOGIC LOG | FROM | TO | PLUGGING INTERVALS |
|------|----|------------------|------|-----|---------------------|
| 0 | 2 | Top Soil | 98 | 101 | Limstone |
| 2 | 14 | Brown Shale | 101 | 108 | Brown Shale |
| 14 | 17 | Limstone | 108 | 118 | Pinkish Brown Shale |
| 17 | 26 | yellow Shale | 118 | 124 | Limstone |
| 26 | 27 | Limstone | 124 | 130 | Grey Shale |
| 27 | 32 | Greenish Shale | | | |
| 32 | 49 | Brown Shale | | | |
| 49 | 52 | Limstone (water) | | | |
| 52 | 55 | Brown Shale | | | |
| 55 | 58 | Greenish Shale | | | |
| 58 | 62 | Brown Shale | | | |
| 62 | 65 | Limstone | | | |
| 65 | 87 | Brown Shale | | | |
| 87 | 90 | Limstone | | | |
| 90 | 98 | Grey Shale | | | |

7 CONTRACTOR'S OR LANDOWNER'S CERTIFICATION: This water well was (1) constructed, (2) reconstructed, or (3) plugged under my jurisdiction and was completed on (mo/day/year) 8/22/94 and this record is true to the best of my knowledge and belief. Kansas Water Well Contractor's License No. 451 This Water Well Record was completed on (mo/day/yr) 8/29/94 under the business name of Haldeman Well Drilling by (signature) [Signature]