

**CORRECTION(S) TO WATER WELL RECORD (WWC-5)**

(to rectify lacking or incorrect information)

County: Pottawatomie

**Location listed as:**

Section-Township-Range: 27-6-11

Fraction (  $\frac{1}{4}$   $\frac{1}{4}$   $\frac{1}{4}$ ): None Given

**Location changed to:**

27-6 S-11 E

SW SW SW SE

**Other changes:** Initial statements: \_\_\_\_\_

Changed to: \_\_\_\_\_

Comments: \_\_\_\_\_

verification method: well address, attached aerial photo, and mapping tool on KGS website.


initials: DRJ date: 3/30/2006

Parcel 7-4070

1 LOCATION OF WATER WELL: Fraction Within City Limits Subdiv R04 Section Number Township Number Range Number  
 County: Pottawatomie  $\frac{1}{4}$   $\frac{1}{4}$   $\frac{1}{4}$  27 6 11 E/W

Distance and direction from nearest town or city street address of well if located within city?  
710 Western Onaga, Ks 66521

2 WATER WELL OWNER: M. James & Lois O. Loucks  
 RR #, St. Address, Box #: 710 Western Board of Agriculture, Division of Water Resources  
 City, State, ZIP Code: Onaga, KS 66521 Application Number: -

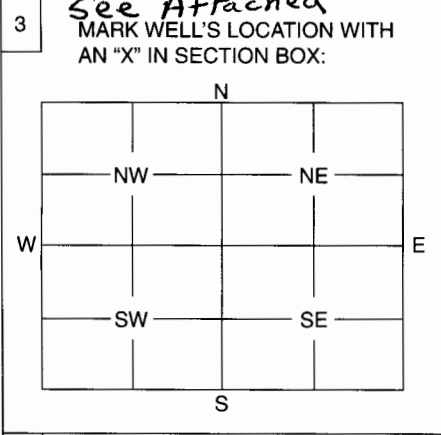

4 DEPTH OF WELL ..... 14 ..... ft.  
 WELL'S STATIC WATER LEVEL ..... 7 ..... ft.  
 WELL WAS USED AS:  
 1 Domestic 2 Irrigation 3 Feedlot 4 Industrial 5 Public Water Supply 6 Oil Field Water Supply 7 Domestic (Lawn & Garden) 8 Air Conditioning 9 Dewatering 10 Monitoring Well 11 Injection Well 12 Other .....

Was a chemical / bacteriological sample submitted to Department? Yes ..... No  .....  
 If yes, mo/day/yr sample was submitted .....

Water Well Disinfected: Yes  No .....

5 TYPE OF BLANK CASING USED:  
 1 Steel 2 PVC 3 RMP (SR) 4 ABS 5 Wrought 6 Asbestos-Cement 7 Fiberglass 8 Concrete Tile 9 Other (Specify below) Hand dug Limestone walls  
 Blank casing diameter ..... in. Was casing removed? Yes  No ..... If yes, how much 5 FT .....  
 Casing height above or below land surface ..... 5 in. before removal

6 GROUT PLUG MATERIAL: 1 Neat cement 2 Cement grout 3 Bentonite 4 Other .....

Grout Plug Intervals: From ..... ft. to ..... ft., From ..... ft. to ..... ft., From ..... to ..... ft.

What is the nearest source of possible contamination:  
 1 Septic tank 2 Sewer lines 3 Watertight sewer lines 4 Lateral lines 5 Cess pool 6 Seepage pit 7 Pit privy 8 Sewage lagoon 9 Feedyard 10 Livestock pens 11 Fuel storage 12 Fertilizer storage 13 Insecticide storage 14 Abandoned water well 15 Oil well/Gas well 16 Other (specify below) .....

Direction from well? South/Southeast How many feet? 26 ft.

FROM	TO	PLUGGING MATERIALS
<u>14'</u>	<u>7'</u>	<u>Washed Coarse Sand</u>
<u>7'</u>	<u>5'</u>	<u>Soil</u>
<u>5'</u>	<u>4 1/2'</u>	<u>Concrete</u>
<u>4 1/2'</u>		<u>Surface Soil</u>

7 CONTRACTOR'S OF LANDOWNER'S CERTIFICATION: This water well was plugged under my jurisdiction and was completed on (mo/day/year) 2/5/06 and this record is true to the best of my knowledge and belief. Kansas Water Well Contractor's License No. .... This Water Well Record was completed on (mo/day/year) 2/5/06 under the business name of - by home owner by (signature) M. James Loucks

INSTRUCTIONS: Use typewriter or ball point pen. Please press firmly and print clearly. Please fill in blanks, underline or circle the correct answers. Send top three copies to Kansas Department of Health and Environment, Bureau of Water, Geology Section, 1000 SW Jackson St., Ste. 420, Topeka, Kansas 66612-1367. Telephone: 785/296-5522. Send one to Water Well Owner and retain one for your records.

# Attachment to Water Well Plugging Record

Water Well Owner: Jim/Lois Loucks  
710 Western      Approximate plugged well location marked ►  
Onaga, KS 66521

Pottawatomie County: Section 27 Township 6 Range 11  
Inside City Limits of Onaga, Kansas  
Roberts Subdivision R04 4090

