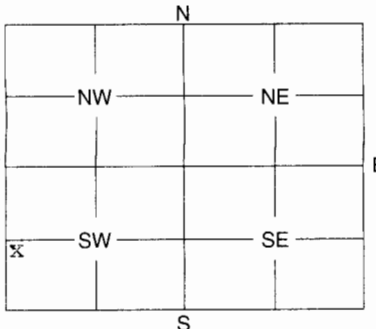


1	LOCATION OF WATER WELL:	Fraction	Section Number	Township Number	Range Number
	County: Pottawatomie	NW ¼ SW ¼ SW ¼	34	06	11 E/W

Distance and direction from nearest town or city street address of well if located within city? 39° 48' 32"
 4278' from Leonard ST & Onaga Bypass intersection to SW 096° 18' 37"


2	WATER WELL OWNER: Darrin E. Figge	Board of Agriculture, Division of Water Resources
	RR #, St. Address, Box #: 515 W Elm	Application Number:
	City, State, ZIP Code : Onaga, KS 66521	

3	MARK WELL'S LOCATION WITH AN "X" IN SECTION BOX:	4	DEPTH OF WELL19.5'..... ft.
			WELL'S STATIC WATER LEVEL17.5' ft.
			WELL WAS USED AS:
			<input checked="" type="checkbox"/> 1 Domestic <input type="checkbox"/> 2 Irrigation <input type="checkbox"/> 3 Feedlot <input type="checkbox"/> 4 Industrial <input type="checkbox"/> 5 Public Water Supply <input type="checkbox"/> 6 Oil Field Water Supply <input type="checkbox"/> 7 Domestic (Lawn & Garden) <input type="checkbox"/> 8 Air Conditioning <input type="checkbox"/> 9 Dewatering <input type="checkbox"/> 10 Monitoring Well <input type="checkbox"/> 11 Injection Well <input type="checkbox"/> 12 Other
			Was a chemical / bacteriological sample submitted to Department? Yes No <input checked="" type="checkbox"/> If yes, mo/day/yr sample was submitted
			Water Well Disinfected: Yes <input checked="" type="checkbox"/> No

5	TYPE OF BLANK CASING USED:
	1 Steel 3 RMP (SR) 5 Wrought 7 Fiberglass 9 Other (Specify below) 2 PVC 4 ABS 6 Asbestos-Cement 8 Concrete Tile
	Blank casing diameter in. Was casing pulled? Yes No If yes, how much
	Casing height above or below land surface in.

6	GROUT PLUG MATERIAL: 1 Neat cement 2 Cement grout <input checked="" type="checkbox"/> 3 Bentonite 4 Other
	Grout Plug Intervals: From ft. to ft., From 5' ft. to 4.5' ft., From to ft.
	What is the nearest source of possible contamination:
	1 Septic tank 6 Seepage pit 11 Fuel storage <input checked="" type="checkbox"/> 16 Other (specify below) 2 Sewer lines 7 Pit privy 12 Fertilizer storage 3 Watertight sewer lines 8 Sewage lagoon 13 Insecticide storage 4 Lateral lines 9 Feedyard 14 Abandoned water well 5 Cess pool 10 Livestock pens 15 Oil well/Gas well Farm field
	Direction from well? S & W How many feet? 30' - 50'

FROM	TO	PLUGGING MATERIALS
19.5'	17.5'	Clean fill Sand
17.5	8.0'	Rock and soil
8.0	5.0	Clean soil
5.0	4.5	Bentonite
4.5	+ 1.5	Clean soil

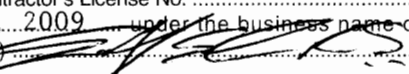7	CONTRACTOR'S OF LANDOWNER'S CERTIFICATION: This water well was plugged under my jurisdiction and was completed on (mo/day/year) <u>April 1, 2009</u> and this record is true to the best of my knowledge and belief. Kansas Water Well Contractor's License No. This Water Well Record was completed on (mo/day/year) <u>April 2, 2009</u> under the business name of <u>Pottawatomie County Environment Health</u> by (signature) 
---	---

INSTRUCTIONS: Use typewriter or ball point pen. Please press firmly and print clearly. Please fill in blanks, underline or circle the correct answers. Send top three copies to Kansas Department of Health and Environment, Bureau of Water, Geology Section, 1000 SW Jackson St., Ste. 420, Topeka, Kansas 66612-1367. Telephone: 785/296-5522. Send one to Water Well Owner and retain one for your records.