✓BRT

61

USE TYPEWRITER OR BALL POINT PEN-PRESS FIRMLY, PRINT CLEARLY.

WATER WELL RECORD
KSA 82a-1201-1215

~~aaa~~ AAD

Kansas Department of Health and Environment-Division of Environment
(Water well Contractors)
Topeka, Kansas 66620

1. Location of well:	County	Fraction	Section number	Township number	Range number
	JACKSON	~~NE~~ SE 1/4 NE 1/4 NE 1/4	6	T 6S S	R 13E E/W

2. Distance and direction from nearest town or city: 3N - 2W - 1/4 S
Street address of well location if in city: OF SOLDIER

3. Owner of well: Mike COE
R.R. or street: RR1
City, state, zip code: Soldier, KANSAS 66540

4. Locate with "X" in section below:

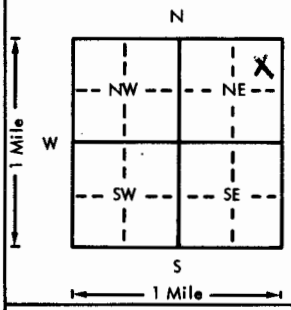

Sketch map:

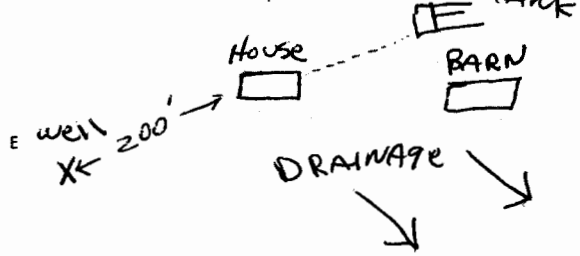

6. Bore hole dia. 10 in. Completion date _____
Well depth 120 ft. 1-6-76

7. __ Cable tool X Rotary __ Driven __ Dug
__ Hollow rod __ Jetted __ Bored __ Reverse rotary

8. Use: ✓ Domestic __ Public supply __ Industry
__ Irrigation __ Air conditioning __ Stock
__ Lawn __ Oil field water __ Other

X. Casing: Material PVC Height: Above or below
Threaded ____ Welded ____ Surface 24 in.
RMP ____ PVC GL Weight 3.88 lbs./ft.
Dia. 5 in. to 120 ft. depth Wall Thickness: inches or
Dia. ____ in. to ____ ft. depth gage No. .258

5. Type and color of material	From	To
TOP SOIL	0	4
BROWN CLAY	4	32
BROWN LIME	32	43
Blue Shale	43	47
BROWN LIME	47	55
yellow Lime (SOFT-BROKEN)	55	60
grey shale	60	87
grey Lime	87	90
Red Shale	90	110
Blue shale	110	120

(Use a second sheet if needed)

10. Screen: Manufacturer's name PUMPCO
Type PVC Dia. 5"
Slot gauze .080 Length 20'
Set between 50 ft. and 70 ft.
____ ft. and ____ ft.
Gravel pack? ✓ Size range of material 1/4 X 1/8

11. Static water level: mo./day/yr.
60 ft. below land surface Date 1-6-76

12. Pumping level below land surfaces: AIR TEST
____ ft. after ____ hrs. pumping ____ g.p.m.
____ ft. after ____ hrs. pumping ____ g.p.m.
Estimated maximum yield 6gpm AT 60' g.p.m.

13. Water sample submitted: mo./day/yr.
__ Yes ✓ No Date ____

14. Well head completion: Capped
__ Pitless adapter 24 Inches above grade

X. Well grouted? ✓
With: ✓ Neat cement ____ Bentonite ____ Concrete
Depth: From X 5 ft. to X 15 ft.

16. Nearest source of possible contamination:
ft. 300 Direction E Type SEPTIC TANK
Well disinfected upon completion? ✓ Yes ____ No

17. Pump: ✓ Not installed
Manufacturer's name ____
Model number ____ HP ____ Volts ____
Length of drop pipe ____ ft. capacity ____ g.p.m.
Type:
__ Submersible __ Turbine
__ Jet __ Reciprocating
__ Centrifugal __ Other

18. Elevation: ~~1276~~ 1302.04
Topography:
✓ Hill
__ Slope
__ Upland
__ Valley

19. Remarks: Owner to Install slab

Bernard Coe

20. Water well contractor's certification:
This well was drilled under my jurisdiction and this report is true to the best of my knowledge and belief.
Business name STRADER DRLG CO INC License No. 182
Address RFD1 Horton, KS
Signed Dale Arbuckle Date 1-8-76
Authorized representative

T 6 R 13 E/W Sec 6 1/4 NE 1/4 NE 1/4 NE 1/4

Forward the white, blue and pink copies to the Department of Health and Environment

Form WWC-5

BR = ~~1264~~ 1270 ▽ = 12~~36~~ 42

MI-1023