


1 LOCATION OF WATER WELL: County: JACKSON	Fraction SE 1/4 NW 1/4 NE 1/4	Section Number 25	Township Number T 6 S	Range Number R 13 E/W
--	----------------------------------	-----------------------------	--------------------------	--------------------------

Distance and direction from nearest town or city street address of well if located within city?
 2 1/2 west, 1/4 south of Circleville

2 WATER WELL OWNER: Fred Diggs
 RR#, St. Address, Box # : Box 31 Board of Agriculture, Division of Water Resources
 City, State, ZIP Code : Netawaka, KS 66516 Application Number:

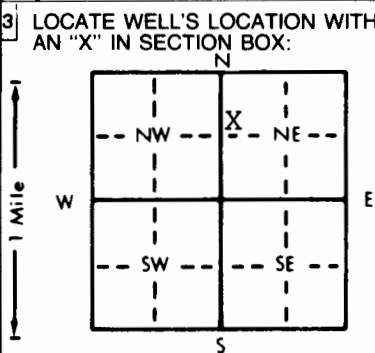

4 DEPTH OF COMPLETED WELL: 97' ft. ELEVATION:
 Depth(s) Groundwater Encountered 1. 88-92 ft. 2. ft. 3. ft.
 WELL'S STATIC WATER LEVEL: 72' ft. below land surface measured on mo/day/yr 5-31-91
 Pump test data: Well water was ft. after hours pumping gpm
 Est. Yield .5 gpm: Well water was ft. after hours pumping gpm
 Bore Hole Diameter: 8 3/4 in. to ft., and in. to ft.
 WELL WATER TO BE USED AS:
 5 Public water supply 8 Air conditioning 11 Injection well
 1 Domestic 3 Feedlot 6 Oil field water supply 9 Dewatering 12 Other (Specify below)
 2 Irrigation 4 Industrial 7 Lawn and garden only 10 Monitoring well
 Was a chemical/bacteriological sample submitted to Department? Yes No **X**; If yes, mo/day/yr sample was submitted
 Water Well Disinfected? Yes **X** No

5 TYPE OF BLANK CASING USED:
 1 Steel 3 RMP (SR) 5 Wrought iron 8 Concrete tile CASING JOINTS: Glued **X** Clamped
 2 PVC 4 ABS 6 Asbestos-Cement 9 Other (specify below) Welded
 7 Fiberglass Threaded
 Blank casing diameter 5" in. to 0-52 ft., Dia 5" in. to 55-77 ft., Dia in. to ft.
 Casing height above land surface 24" in., weight 2.82 lbs./ft. Wall thickness or gauge No. 258
 TYPE OF SCREEN OR PERFORATION MATERIAL:
 1 Steel 3 Stainless steel 5 Fiberglass 7 PVC 10 Asbestos-cement
 2 Brass 4 Galvanized steel 6 Concrete tile 8 RMP (SR) 11 Other (specify)
 12 None used (open hole)
 SCREEN OR PERFORATION OPENINGS ARE:
 1 Continuous slot 3 Mill slot 5 Gauzed wrapped 8 Saw cut 11 None (open hole)
 2 Louvered shutter 4 Key punched 6 Wire wrapped 9 Drilled holes
 7 Torch cut 10 Other (specify)
 SCREEN-PERFORATED INTERVALS: From 52 ft. to 55 ft., From ft. to ft.
 From 77 ft. to 97 ft., From ft. to ft.
 GRAVEL PACK INTERVALS: From 24 ft. to 97 ft., From ft. to ft.
 From ft. to ft., From ft. to ft.

6 GROUT MATERIAL: 1 Neat cement 2 Cement grout 3 Bentonite 4 Other **hole plug**
 Grout intervals: From 0 ft. to 24 ft., From ft. to ft., From ft. to ft.
 What is the nearest source of possible contamination:
 1 Septic tank 4 Lateral lines 7 Pit privy 10 Livestock pens 14 Abandoned water well
 2 Sewer lines 5 Cess pool 8 Sewage lagoon 11 Fuel storage 15 Oil well/Gas well
 3 Watertight sewer lines 6 Seepage pit 9 Feedyard 12 Fertilizer storage 16 Other (specify below)
 13 Insecticide storage
 Direction from well? north How many feet? 220'

FROM	TO	LITHOLOGIC LOG	FROM	TO	PLUGGING INTERVALS
0	3	Top Soil	76	77	Limestone-Yellow
3	21	Clay-Brown	77	83	Shale-Yellow
21	45	Clay-Blue	83	84	Limestone-Yellow
45	46	Fine Sand-Blue	84	88	Shale-Red
46	51	Clay-Blue	88	92	Limestone-Yellow-Loose
51	54	Chert, Boulders 1/2x1/2	92	97	Limestone-Grey
54	57	Shale-grey			
57	60	Limestone-Grey			
60	63	Shale-Grey			
63	65	Limestone-Grey			
65	69	Shale-Grey			
69	71	Limestone-Yellow			
71	72	Shale-Yellow			
72	75	Limestone-Grey			
75	76	Shale-Grey			

7 CONTRACTOR'S OR LANDOWNER'S CERTIFICATION: This water well was (1) constructed, (2) reconstructed, or (3) plugged under my jurisdiction and was completed on (mo/day/year) 5-31-91 and this record is true to the best of my knowledge and belief. Kansas Water Well Contractor's License No. 182 This Water Well Record was completed on (mo/day/yr) 6-18-91 under the business name of STRADER DRILLING CO., INC. by (signature) *Dale W. Strader*