

6

VBR T

USE TYPEWRITER OR BALL POINT PEN-PRESS FIRMLY, PRINT CLEARLY.

WATER WELL RECORD
KSA 82a-1201-1215


T R EW sec 1/4 1/4 1/4 No.

Kansas State Dept. Of Health
(Water Well Contractors)
Forbes-Bldg. 740
Topeka, Kansas 66620

cdd

1 Location of well:	County JACKSON	Township name Soldier	Fraction TRACT SW 1/4	Section number 34	Town number T6S	Range number R13E
---------------------	--------------------------	---------------------------------	------------------------------------	-----------------------------	---------------------------	-----------------------------

Distance and direction from nearest town or city: Street address of well location if in city: 11W, 1N, 1/2 E of HOLTON, KANS.	3 Owner of well: Address: Bay Real Estate TOPEKA, KANS. (Steve Johnston)
--	---

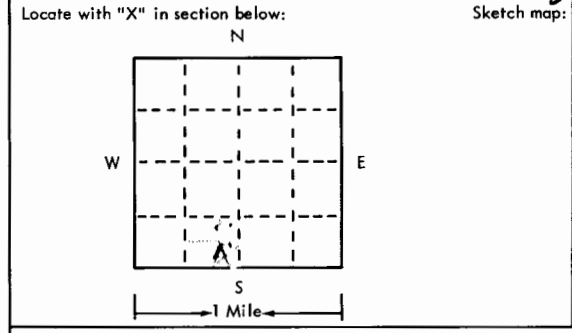

4 Well depth: 100 ft. Date of completion 1-20-75 Well diameter 8 in.
5 <input type="checkbox"/> Cable tool <input checked="" type="checkbox"/> Rotary <input type="checkbox"/> Driven <input type="checkbox"/> Dug <input type="checkbox"/> Hollow rod <input type="checkbox"/> Jetted <input type="checkbox"/> Bored <input type="checkbox"/> Reverse rotary
6 Use: <input checked="" type="checkbox"/> Domestic <input type="checkbox"/> Public supply <input type="checkbox"/> Industry <input type="checkbox"/> Irrigation <input type="checkbox"/> Air conditioning <input type="checkbox"/> Commercial <input type="checkbox"/> Test well
7 Casing: Material PVC Height: above/below Threaded <input type="checkbox"/> Welded <input type="checkbox"/> Surface 24 in. Diam. Weight 2.33 lbs./ft. 5 in. to 100 ft. depth Drive shoe? <input type="checkbox"/> Yes <input checked="" type="checkbox"/> No

2	Type and color of material	From	To
	0-3 Top Soil	0	3
	3-21 Yellow Clay	3	21
	21-35 yellow shale	21	35
	35-37 White Limestone	35	37
	37-45 Grey Shale	37	45
	45-49 Blue Limestone	45	49
	49-67 Grey Shale	49	67
	67-69 Grey limestone	67	69
	69-75 Grey Shale	69	75
	75-78 White Limestone	75	78
	78-100 Blue Shale	78	100

8 Screen: Manufacturer PumpCo Type PVC Dia. 5" Slot/gauge .080 Length 20 Set between 80 ft. and 100 ft. Fittings: Gravel pack <input checked="" type="checkbox"/> Yes <input type="checkbox"/> No Size range of material 1/8"
9 Static water level: NOT MEASURED ft. below land surface Date
10 Pumping level below land surfaces AIR TEST ft. after hrs. pumping g.p.m. ft. after hrs. pumping g.p.m. Estimated maximum yield 30 g.p.m.
11 Water sample submitted: <input type="checkbox"/> Yes <input checked="" type="checkbox"/> No Date
12 Well head completion: <input checked="" type="checkbox"/> Pitless adapter 24" <input type="checkbox"/> Inches above grade
13 Well grouted? <input checked="" type="checkbox"/> Yes <input type="checkbox"/> No <input checked="" type="checkbox"/> Neat cement <input type="checkbox"/> Bentonite <input type="checkbox"/> Depth: From 0 ft. to 10 ft.
14 Nearest source of possible contamination: ft. 200 Direction WEST Type SEPTIC TANK Well disinfected upon completion? <input checked="" type="checkbox"/> Yes <input type="checkbox"/> No
15 Pump: <input checked="" type="checkbox"/> Not installed Manufacturer's name Model number HP Volts Length of drop pipe ft. capacity g.m.p. Type: <input type="checkbox"/> Submersible <input type="checkbox"/> Turbine <input type="checkbox"/> Jet <input type="checkbox"/> Reciprocating <input type="checkbox"/> Centrifugal <input type="checkbox"/> Other

16 Remarks: elevation **1180'**
Topography:
 Hill
 Slope
 Upland
 Valley

17 Water well contractor's certification:
This well was drilled under my jurisdiction and this report is true to the best of my knowledge and belief.
Strader Drilling Co. Inc. #182
Business name License No.
Address **RR1 Hwy. 75N Holton, KANS.**
Signed **Dale Johnson** Date **1-28-75**
Authorized representative

ADD MEAS
61
11T