2045

WATER WELL RECORD Form WWC-5 KSA 82a-1212 ID No. _____

1 LOCATION OF WATER WELL: County: JACKSON | Fraction: NE ¼ NE ¼ SE ¼ | Section Number: 11 | Township Number: T 6 S | Range Number: R 13 E W

Distance and direction from nearest town or city street address of well if located within city?
FROM HOLTON: 9 MILES WEST ON HWY 16 AND ½ MILE SOUTH

2 WATER WELL OWNER: C.W. BEIGHTEL
RR#, St. Address, Box # : 1867 E. 1500 RD
City, State, ZIP Code : LAWRENCE, KS
Board of Agriculture, Division of Water Resources Application Number: —

3 LOCATE WELL'S LOCATION WITH AN "X" IN SECTION BOX:

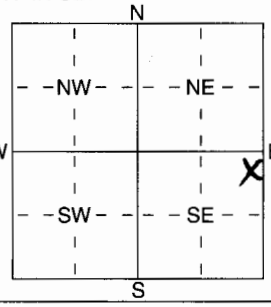

4 DEPTH OF COMPLETED WELL 122 ft. ELEVATION: —
Depth(s) Groundwater Encountered 1 108 ft. 2 — ft. 3 — ft.
WELL'S STATIC WATER LEVEL 92.5 ft. below land surface measured on mo/day/yr 3/7/05
Pump test data: Well water was — ft. after — hours pumping — gpm
Est. Yield 12 gpm: Well water was — ft. after — hours pumping — gpm
WELL WATER TO BE USED AS: (1) Domestic 2 Irrigation 3 Feedlot 4 Industrial 5 Public water supply 6 Oil field water supply 7 Domestic (lawn & garden) 8 Air conditioning 9 Dewatering 10 Monitoring well 11 Injection well 12 Other (Specify below)
Was a chemical/bacteriological sample submitted to Department? Yes ..... No X ; If yes, mo/day/yrs sample was submitted
Water Well Disinfected? Yes X No

5 TYPE OF BLANK CASING USED: (2) PVC 1 Steel 3 RMP (SR) 4 ABS 5 Wrought iron 6 Asbestos-Cement 7 Fiberglass 8 Concrete tile 9 Other (specify below)
CASING JOINTS: Glued X Clamped — Welded — Threaded —
Blank casing diameter 5 in. to 102 ft., Dia — in. to — ft., Dia — in. to — ft.
Casing height above land surface 24 in., weight — lbs./ft. Wall thickness or guage No. SDR 21

TYPE OF SCREEN OR PERFORMANCE MATERIAL: (2) PVC 1 Steel 2 Brass 3 Stainless Steel 4 Galvanized Steel 5 Fiberglass 6 Concrete tile 8 RMP (SR) 9 ABS 10 Asbestos-Cement 11 Other (Specify) 12 None used (open hole)

SCREEN OR PERFORATION OPENINGS ARE: 1 Continuous slot (3) Mill slot 2 Louvered shutter 4 Key punched 5 Guazed wrapped 6 Wire wrapped 7 Torch cut 8 Saw cut 9 Drilled holes 10 Other (specify) 11 None (open hole)

SCREEN-PERFORATED INTERVALS: From 102 ft. to 122 ft., From — ft. to — ft.
From — ft. to — ft., From — ft. to — ft.
GRAVEL PACK INTERVALS: From 25 ft. to 122 ft., From — ft. to — ft.
From — ft. to — ft., From — ft. to — ft.

6 GROUT MATERIAL: 1 Neat cement 2 Cement grout (3) Bentonite 4 Other
Grout Intervals: From 3 ft. to 25 ft., From — ft. to — ft., From — ft. to — ft.
What is the nearest source of possible contamination: 1 Septic tank 2 Sewer lines 3 Watertight sewer lines 4 Lateral lines 5 Cess pool 6 Seepage pit 7 Pit privy 8 Sewage lagoon 9 Feedyard 10 Livestock pens 11 Fuel storage 12 Fertilizer storage 13 Insecticide storage 14 Abandoned water well 15 Oil well/Gas well (16) Other (specify below)
Direction from well? EAST How many feet? 20 EXISTING WELL WILL BE PLUGGED

FROM	TO	LITHOLOGIC LOG	FROM	TO	PLUGGING INTERVALS
0	8	CLAY, BROWN	113	122	SHALE, GRAY
8	12	SAND, RED W/ CLAY			
12	19	CLAY, BROWN			
19	20	LIMESTONE			
20	26	SHALE, GRAY			
26	36	LIMESTONE			
36	42	SHALE, DARK GRAY TO GRAY			
42	44	LIMESTONE, GRAY			
44	51	SHALE, GRAY			
51	53	LIMESTONE			
53	59	SHALE, RED TO GRAY			
59	60	LIMESTONE			
60	108	SHALE, GRAY			
108	113	SANDSTONE, GRAY H2O			

7 CONTRACTOR'S OR LANDOWNER'S CERTIFICATION: This water well was (1) constructed, (2) reconstructed, or (3) plugged under my jurisdiction and was completed on (mo/day/year) 3/7/05 and this record is true to the best of my knowledge and belief. Kansas Water Well Contractor's Licence No 585 This Water Well Record was completed on (mo/day/yr) 3/23/05 under the business name of ASSOCIATED ENVIRONMENTAL INC by (signature)

INSTRUCTIONS: Use typewriter or ball point pen. *PLEASE PRESS FIRMLY* and *PRINT* clearly. Please fill in blanks, underline or circle the correct answers. Send top three copies to Kansas Department of Health and Environment, Bureau of Water, Geology Section, 1000 SW Jackson St., Suite 420, Topeka, Kansas 66612-1367. Telephone 785-296-5522. Send one to WATER WELL OWNER and retain one for your records. Fee of $5.00 for each constructed well.