

CORRECTION(S) TO WATER WELL RECORD (WWC-5)  
(to rectify lacking or incorrect information)

County: Jackson

Location listed as:

Location changed to:

Section-Township-Range: 20-06-13 E

20-65-13 E

Fraction ( 1/4 1/4 1/4): None Given

NW SW SW

Other changes: Initial statements: \_\_\_\_\_

Changed to: \_\_\_\_\_

Comments: \_\_\_\_\_

verification method: Written & legal descriptions, position on plat map,  
and mapping tool & aerial photos on KGS website.


initials: DRF date: 8/18/2009

submitted by: Kansas Geological Survey, Data Resources Library, 1930 Constant Ave., Lawrence, KS 66047-3726  
to: Kansas Dept of Health & Environment, Bureau of Water, 1000 SW Jackson, Suite 420, Topeka, KS 66612-1367.

1 LOCATION OF WATER WELL: County: <u>Jackson</u>	Fraction $\frac{1}{4}$ $\frac{1}{4}$ $\frac{1}{4}$	Section Number <u>20</u>	Township Number <u>06</u>	Range Number <u>13</u> <small>EW</small>
---	---	-----------------------------	------------------------------	---

Distance and direction from nearest town or city street address of well if located within city?  
From Soldier, ks. go 2mi West then 2 3/4 South (Left side of Road.)

2 WATER WELL OWNER: RR#, St. Address, Box #: <u>David E. Penrod</u> <u>1405 262 #4</u> City, State ZIP Code: <u>Soldier, ks.</u> <u>66540</u>	Global Positioning Systems (decimal degrees, min. of 4 digits) Latitude: _____ Longitude: _____ Elevation: _____ Datum: _____ Data Collection Method: _____
---	--

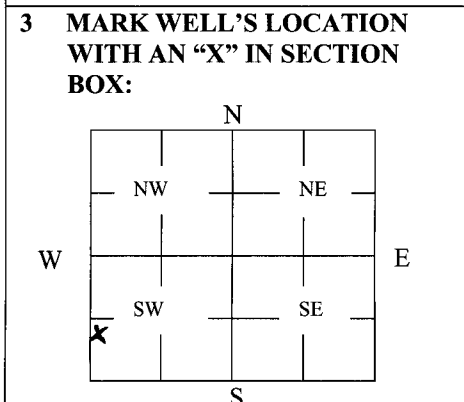

4 DEPTH OF WELL 44 ft.  
 WELL'S STATIC WATER LEVEL 8' ft.  
 WELL WAS USED AS:  
 1 Domestic      5 Public Water Supply      9 Dewatering  
 2 Irrigation      6 Oil Field Water Supply      10 Monitoring  
 3 Feedlot      7 Domestic (Lawn & Garden)      11 Injection Well  
 4 Industrial      8 Air Conditioning      12 Other Not used for years.

Was a chemical/bacteriological sample submitted to Department? Yes \_\_\_\_\_ No

5 TYPE OF BLANK CASING USED:  
 1 Steel      3 RMP (SR)      5 Wrought      7 Fiberglass      9 Other (Specify below)  
 2 PVC      4 ABS      6 Asbestos-Cement      8 Concrete Tile      It had old steep pipe in it.

Blank casing diameter 2 in. Was casing pulled? Yes  No \_\_\_\_\_ If yes, how much All of it!  
 Casing height above or below land surface All outin.

6 GROUT PLUG MATERIAL:      1 Neat cement      2 Cement grout       3 Bentonite      4 Other Natural Clay  
Sand & Gravel  
 Grout Plug Intervals: From 0 ft. to 8' ft., From 8' ft. to 34' ft., From 34 to 39 ft.  
Near Back Hill to surface with surface soils

What is the nearest source of possible contamination:  
 1 Septic tank      6 Seepage pit      11 Fuel Storage      16 Other (specify below) None  
 2 Sewer lines      7 Pit privy      12 Fertilizer storage      It's a Hay field  
 3 Watertight sewer lines      8 Sewage lagoon      13 Insecticide storage  
 4 Lateral lines      9 Feedyard      14 Abandoned water well      Direction from well? \_\_\_\_\_  
 5 Cess pool      10 Livestock pens      15 Oil well/Gas well      How many feet? \_\_\_\_\_

FROM	TO	PLUGGING MATERIALS	FROM	TO	PLUGGING MATERIALS
$\emptyset$	$\emptyset$	<u>2 gallons of Chlorine Bleach then knock down top 5' of well wall</u>			
$\emptyset$	<u>8'</u>	<u>Sand &amp; Gravel</u>			
<u>8'</u>	<u>34'</u>	<u>Natural Clay</u>			
<u>34'</u>	<u>39'</u>	<u>Bentonite</u>			
<u>39'</u>	<u>44'</u>	<u>Back Hill with surface soils</u>			

7 ~~CONTRACTOR'S~~ OR LANDOWNER'S CERTIFICATION: This water well was plugged under my jurisdiction and was completed on (mo/day/year) 7-24-09 and this record is true to the best of my knowledge and belief. Kansas Water Well Contractor's License No. \_\_\_\_\_. This Water Well Record was completed on (mo/day/year) \_\_\_\_\_ under the business name of \_\_\_\_\_ by (signature) David E. Penrod

INSTRUCTIONS: Use typewriter or ballpoint pen. Please press firmly and print clearly. Please fill in blanks, underline or circle the correct answers. Send top three copies to Kansas Department of Health and Environment, Bureau of Water, Geology Section, 1000 SW Jackson St., Ste. 420, Topeka, Kansas 66612-1367. Telephone: 785/296-5522. Send one to Water Well Owner and retain one for your records. Visit us at <http://www.kdheks.gov/geo/waterwells>.