


1 LOCATION OF WATER WELL: Fraction SE 1/4 NW 1/4 SW 1/4 Section Number 25 Township Number T 6 S Range Number R 13 EXX
 County: Jackson

Distance and direction from nearest town or city street address of well if located within city?

2 WATER WELL OWNER: Dan McKinney Project #OK 93-L120
 RR#, St. Address, Box # Oklahoma City Area Indian Health Service Board of Agriculture, Division of Water Resources
 City, State, ZIP Code 3625 N.W. 56th St., Oklahoma, OK 73112 Application Number:

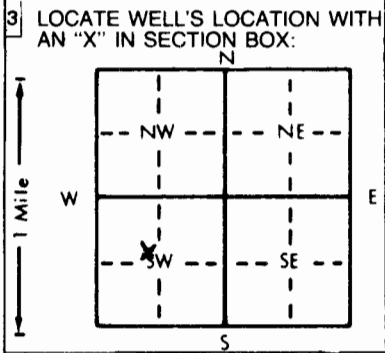

4 DEPTH OF COMPLETED WELL: 100 ft. ELEVATION:
 Depth(s) Groundwater Encountered 1. ft. 2. ft. 3. ft.
 WELL'S STATIC WATER LEVEL: 30 ft. below land surface measured on mo/day/yr 10-20-94
 Pump test data: Well water was ft. after 3 hours pumping gpm
 Est. Yield 2 gpm: Well water was ft. after hours pumping gpm
 Bore Hole Diameter 9 in. to ft. and in. to ft.
 WELL WATER TO BE USED AS:
 1 Domestic 3 Feedlot 6 Oil field water supply 9 Dewatering 12 Other (Specify below)
 2 Irrigation 4 Industrial 7 Lawn and garden only 10 Monitoring well
 Was a chemical/bacteriological sample submitted to Department? Yes No X; If yes, mo/day/yr sample was sub-
 mitted Water Well Disinfected? Yes X No

5 TYPE OF BLANK CASING USED:
 1 Steel 3 RMP (SR) 5 Wrought iron 8 Concrete tile CASING JOINTS: Glued X Clamped
 2 PVC 4 ABS 6 Asbestos-Cement 9 Other (specify below) Welded
 7 Fiberglass Threaded
 Blank casing diameter 5 in. to 25 ft. Dia 5 in. to 45-60 ft. Dia 5 in. to 80-100 ft.
 Casing height above land surface 12 in. weight 2.843 lbs./ft. Wall thickness or gauge No. SDR 21
 TYPE OF SCREEN OR PERFORATION MATERIAL:
 1 Steel 3 Stainless steel 5 Fiberglass 7 PVC 10 Asbestos-cement
 2 Brass 4 Galvanized steel 6 Concrete tile 8 RMP (SR) 11 Other (specify)
 9 ABS 12 None used (open hole)
 SCREEN OR PERFORATION OPENINGS ARE:
 1 Continuous slot 3 Mill slot 5 Gauzed wrapped 8 Saw cut 11 None (open hole)
 2 Louvered shutter 4 Key punched 6 Wire wrapped 9 Drilled holes
 7 Torch cut 10 Other (specify)
 SCREEN-PERFORATED INTERVALS: From 25 ft. to 45 ft. From ft. to ft.
 From 60 ft. to 80 ft. From ft. to ft.
 GRAVEL PACK INTERVALS: From 22 ft. to 100 ft. From ft. to ft.
 From ft. to ft. From ft. to ft.

6 GROUT MATERIAL: 1 Neat cement 2 Cement grout 3 Bentonite 4 Other
 Grout Intervals: From 3 ft. to 22 ft. From ft. to ft. From ft. to ft.
 What is the nearest source of possible contamination:
 1 Septic tank 4 Lateral lines 7 Pit privy 10 Livestock pens 14 Abandoned water well
 2 Sewer lines 5 Cess pool 8 Sewage lagoon 11 Fuel storage 15 Oil well/Gas well
 3 Watertight sewer lines 6 Seepage pit 9 Feedyard 12 Fertilizer storage 16 Other (specify below)
 13 Insecticide storage None known

Direction from well? How many feet?

FROM	TO	LITHOLOGIC LOG	FROM	TO	PLUGGING INTERVALS
0	5	No Sample	57	58	limestone - med. gray
5	8	sandy clay - brn	58	58.5	shale - med. gray
8	8.5	limestone - lt. gray	58.5	59	limestone - med. gray
8.5	10.5	shale - brn	59	63.5	shale - med. gray
10.5	11.5	limestone - gray	63.5	65.4	limestone - gray
11.5	24	shale - olive	65.4	76.5	shale - gray
24	32	shale - gray	76.5	78	limestone - gray
32	42	limestone - gray	78	80	shale - gray
42	46	shale - gray	80	81.5	limestone - gray
46	47.5	shale - drk. gray	81.5	100	shale - gray
47.5	50	limestone - med. gray			
50	52.5	shale - gray			
52.5	53.5	limestone - gray			
53.5	56	shale - gray			
56	57	shale - drk. gray			

7 CONTRACTOR'S OR LANDOWNER'S CERTIFICATION: This water well was (1) constructed, (2) reconstructed, or (3) plugged under my jurisdiction and was completed on (mo/day/year) September 19, 1994 and this record is true to the best of my knowledge and belief. Kansas Water Well Contractor's License No. 308 This Water Well Record was completed on (mo/day/yr) December 15, 1994 under the business name of Rieschick Drilling Company by (signature) *Ray R. ...*

000422