


1 LOCATION OF WATER WELL: Fraction SE 1/4 SE 1/4 NE 1/4 Section Number 7 Township Number T 6 S Range Number R 14 EW
 County: JACKSON

Distance and direction from nearest town or city street address of well if located within city?
 1 1/2 west, 2 3/4 N. of Circleville

2 WATER WELL OWNER: Richard Dugan
 RR#, St. Address, Box # : 24374 F Rd. Board of Agriculture, Division of Water Resources
 City, State, ZIP Code : Soldier, KS 66540 Application Number:

3 LOCATE WELL'S LOCATION WITH AN "X" IN SECTION BOX:

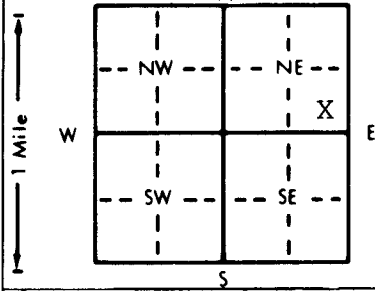

4 DEPTH OF COMPLETED WELL... 130' ft. ELEVATION:

Depth(s) Groundwater Encountered 1. 117' ft. 2. ft. 3. ft.
 WELL'S STATIC WATER LEVEL . 90' ft. below land surface measured on mo/day/yr . 8/23/96
 Pump test data: Well water was ft. after hours pumping gpm
 Est. Yield . 10 gpm: Well water was ft. after hours pumping gpm
 Bore Hole Diameter . 8 3/4 in. to ft., and in. to ft.
 WELL WATER TO BE USED AS: 5 Public water supply 8 Air conditioning 11 Injection well
 1 Domestic 3 Feedlot 6 Oil field water supply 9 Dewatering 12 Other (Specify below)
 2 Irrigation 4 Industrial 7 Lawn and garden only 10 Monitoring well
 Was a chemical/bacteriological sample submitted to Department? Yes No X; If yes, mo/day/yr sample was submitted
 Water Well Disinfected? Yes X No

5 TYPE OF BLANK CASING USED: 5 Wrought iron 8 Concrete tile CASING JOINTS: Glued X Clamped
 1 Steel 3 RMP (SR) 6 Asbestos-Cement 9 Other (specify below) Welded
 2 PVC 4 ABS 7 Fiberglass Threaded

Blank casing diameter . 5" in. to 0-90 ft., Dia . in. to ft., Dia . in. to ft.
 Casing height above land surface . 24" in., weight . 2.82 lbs./ft. Wall thickness or gauge No. . 258

TYPE OF SCREEN OR PERFORATION MATERIAL: 7 PVC 10 Asbestos-cement
 1 Steel 3 Stainless steel 5 Fiberglass 8 RMP (SR) 11 Other (specify)
 2 Brass 4 Galvanized steel 6 Concrete tile 9 ABS 12 None used (open hole)

SCREEN OR PERFORATION OPENINGS ARE: 5 Gauzed wrapped 8 Saw cut 11 None (open hole)
 1 Continuous slot 3 Mill slot 6 Wire wrapped 9 Drilled holes
 2 Louvered shutter 4 Key punched 7 Torch cut 10 Other (specify)

SCREEN-PERFORATED INTERVALS: From . 90 ft. to . 130 ft., From ft. to ft.
 From ft. to ft., From ft. to ft.

GRAVEL PACK INTERVALS: From . 24 ft. to . 130 ft., From ft. to ft.
 From ft. to ft., From ft. to ft.

6 GROUT MATERIAL: 1 Neat cement 2 Cement grout 3 Bentonite 4 Other
 Grout Intervals: From . 4 ft. to . 24 ft., From ft. to ft., From ft. to ft.

What is the nearest source of possible contamination: 10 Livestock pens 14 Abandoned water well
 1 Septic tank 4 Lateral lines 7 Pit privy 11 Fuel storage 15 Oil well/Gas well
 2 Sewer lines 5 Cess pool 8 Sewage lagoon 12 Fertilizer storage 16 Other (specify below)
 3 Watertight sewer lines 6 Seepage pit 9 Feedyard 13 Insecticide storage

Direction from well? north How many feet? 100'

FROM	TO	LITHOLOGIC LOG	FROM	TO	PLUGGING INTERVALS
0	2	Top Soil			
2	38	Clay-Brown			
38	73	Clay-Blue			
73	94	Shaley LS Yellow			
94	95	Limestone-Yellow			
95	114	Shale-Yellow			
114	117	Limestone-Y-Loose			
117	130	Shale-Grey			

7 CONTRACTOR'S OR LANDOWNER'S CERTIFICATION: This water well was (1) constructed, (2) reconstructed, or (3) plugged under my jurisdiction and was completed on (mo/day/year) . 8/23/96 and this record is true to the best of my knowledge and belief. Kansas
 Water Well Contractor's License No. 182 This Water Well Record was completed on (mo/day/yr) . 9-10-96
 under the business name of STRADER DRILLING CO., INC. by (signature) Dale Skoren