55 - formerly 546

USE TYPEWRITER OR BALL POINT PEN-PRESS FIRMLY, PRINT CLEARLY.

date wrong

WATER WELL RECORD
KSA 82a-1201-1215

daa

Kansas Department of Health and Environment-Division of Environment
(Water well Contractors)
Topeka, Kansas 66620

1. Location of well:	County	Fraction	Section number	Township number	Range number
	JACKSON	NE 1/4 NE 1/4 SE 1/4	2	T 6 (S)	R 14 (E) W

2. Distance and direction from nearest town or city: 3 N 2 E

Street address of well location if in city: OF CIRCLE VILLE

3. Owner of well: Floyd LACEY . SR.

R.R. or street:

City, state, zip code: WETMORE Rfd 66550

4. Locate with "X" in section below:

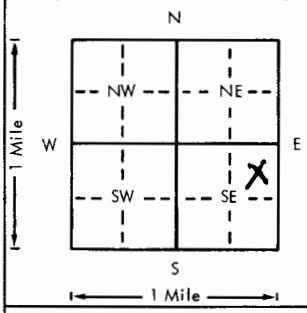

Sketch map:

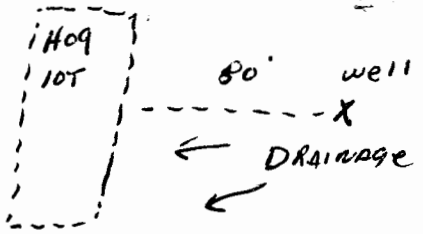

6. Bore hole dia. 10 in. Completion date 1-11-79
Well depth 137 ft.

7. __ Cable tool ✓ Rotary __ Driven __ Dug
__ Hollow rod __ Jetted __ Bored __ Reverse rotary

8. Use: ✓ Domestic __ Public supply __ Industry
__ Irrigation __ Air conditioning __ Stock
__ Lawn __ Oil field water __ Other

9. Casing: Material PVC Height: (Above) or below
Threaded ___ Welded ___ Surface 24 in.
RMP ___ PVC PL Weight 2.82 lbs./ft.
Dia. 5 in. to 137 ft. depth Wall Thickness: inches or
Dia. ___ in. to ___ ft. depth gage No. .258

10. Screen: Manufacturer's name Rumpco mfg
Type PVC Dia. 5
(Slot) gauze .020 Length 30
Set between 100 ft. and 130 ft.
___ ft. and ___ ft.
Gravel pack? ✓ Size range of material .030x.060

11. Static water level: mo./day/yr.
88 ft. below land surface Date 1-11-79

12. Pumping level below land surfaces:
___ ft. after ___ hrs. pumping ___ g.p.m.
___ ft. after ___ hrs. pumping ___ g.p.m.
Estimated maximum yield 50 g.p.m.

13. Water sample submitted: mo./day/yr.
__ Yes ✓ No Date

14. Well head completion: CAP
__ Pitless adapter 24 Inches above grade

15. Well grouted? ✓
With: ✓ Neat cement __ Bentonite __ Concrete
Depth: From 0 ft. to 10 ft.

16. Nearest source of possible contamination:
ft. 80 Direction W Type LOTS
Well disinfected upon completion? ✓ Yes __ No

17. Pump: __ Not installed
Manufacturer's name
Model number ___ HP ___ Volts ___
Length of drop pipe ___ ft. capacity ___ g.p.m.
Type:
__ Submersible __ Turbine
__ Jet __ Reciprocating
__ Centrifugal __ Other

5. Type and color of material	From	To
TOP SOIL	0	3
CLAY, BROWN, blue	3	60
FINE SAND, COURSE SAND, WATER BEARING	60	70
CLAY, blue	70	100
COURSE SAND, med gr, fea gr. WATER BEARING	100	110
CLAY, blue	110	120
CHERT GRAVEL, DIRTY, PEA SIZE	120	127
SHALE, GREY	127	137

(Use a second sheet if needed)

18. Elevation: 1160

Topography:
✓ Hill
__ Slope
__ Upland
__ Valley

19. Remarks:
OWNER TO INSTALL SLAB

20. Water well contractor's certification:
This well was drilled under my jurisdiction and this report is true to the best of my knowledge and belief.
STRADER DRLG CO 182
Business name License No.
Address RT 1 Holton KS
Signed Dale Aaken Date 1-12-79
Authorized representative

T 6 R 14 (E) W Sec 2 1/4 1/4 1/4 1/4 NE SE

Forward the white, blue and pink copies to the Department of Health and Environment

Form WWC-5

1072 1033

MI-1023