


V BRT

7

USE TYPEWRITER OR BALL POINT PEN-PRESS FIRMLY, PRINT CLEARLY.

WATER WELL RECORD  
KSA 82a-1201-1215

000

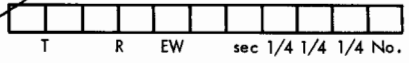

Kansas State Dept. Of Health  
(Water Well Contractors)  
Forbes-Bldg. 740  
Topeka, Kansas 66620

1 Location of well:		County <b>JACKSON</b>	Township name <b>JEFFERSON</b>	Fraction <b>TRACT</b> <b>NE 1/4 - NE 1/4</b>	Section number <b>12</b>	Town number <b>65</b>	Range number <b>14 E</b>
Distance and direction from nearest town or city: <b>9 N.W. HOLTON</b>				3 Owner of well: <b>RICHARD ARMSTRONG</b>			
Street address of well location if in city: <b>KS.</b>				Address: <b>RFD 3 HOLTON, KANSAS 66436</b>			
Locate with "X" in section below:		Sketch map:		4 Well depth: <b>103</b> ft. Date of completion <b>6-13-75</b> Well diameter <b>8</b> in.			
				5 <input type="checkbox"/> Cable tool <input checked="" type="checkbox"/> Rotary <input type="checkbox"/> Driven <input type="checkbox"/> Dug <input type="checkbox"/> Hollow rod <input type="checkbox"/> Jetted <input type="checkbox"/> Bored <input type="checkbox"/> Reverse rotary			
2		Type and color of material		From	To	6 Use: <input checked="" type="checkbox"/> Domestic <input type="checkbox"/> Public supply <input type="checkbox"/> Industry <input type="checkbox"/> Irrigation <input type="checkbox"/> Air conditioning <input type="checkbox"/> Commercial <input type="checkbox"/> Test well	
		<b>Top Soil</b>		<b>0</b>	<b>1</b>	7 Casing: Material <b>PVC</b> Height: above/below Threaded <input type="checkbox"/> Welded <input type="checkbox"/> Surface <b>24</b> in. Diam. Weight <b>2.33</b> lbs./ft. <b>5</b> in. to <b>103</b> ft. depth Drive shoe? <input type="checkbox"/> Yes <input checked="" type="checkbox"/> No	
		<b>Yellow Clay</b>		<b>1</b>	<b>38</b>	8 Screen: Manufacturer <b>Pumpco</b> Type <b>PVC</b> Dia. <b>5"</b> Slot/gauge <b>1025</b> Length <b>20'</b> Set between <b>90</b> ft. and <b>90</b> ft. Fittings: Gravel pack <input checked="" type="checkbox"/> Yes <input type="checkbox"/> No Size range of material <b>#3</b>	
		<b>" Sand</b>		<b>38</b>	<b>41</b>	9 Static water level: <b>NOT MEASURED</b> ft. below land surface Date	
		<b>Grey Clay</b>		<b>41</b>	<b>51</b>	10 Pumping level below land surfaces: <b>Air Test</b> ft. after hrs. pumping g.p.m. ft. after hrs. pumping g.p.m. Estimated maximum yield <b>10</b> g.p.m.	
		<b>" Sand</b>		<b>51</b>	<b>57</b>	11 Water sample submitted: <input type="checkbox"/> Yes <input checked="" type="checkbox"/> No Date	
		<b>Yellow Sand - Fine sand + Boulders</b>		<b>57</b>	<b>69</b>	12 Well head completion: <b>CAPPED</b> <input type="checkbox"/> Pitless adapter <b>24</b> <input checked="" type="checkbox"/> Inches above grade	
		<b>COARSE GRAVEL + Boulders</b>		<b>69</b>	<b>80</b>	13 Well grouted? <input checked="" type="checkbox"/> Yes <input type="checkbox"/> No <input checked="" type="checkbox"/> Neat cement <input type="checkbox"/> Bentonite Depth: From <b>0</b> ft. to <b>10</b> ft.	
		<b>Grey Clay</b>		<b>80</b>	<b>84</b>	14 Nearest source of possible contamination: ft. <b>150</b> Direction <b>N.E</b> Type <b>S. Tank</b> Well disinfected upon completion? <input checked="" type="checkbox"/> Yes <input type="checkbox"/> No	
		<b>COARSE GRAVEL</b>		<b>84</b>	<b>90</b>	15 Pump: <input checked="" type="checkbox"/> Not installed Manufacturer's name Model number HP Volts Length of drop pipe ft. capacity g.p.m. Type: <input type="checkbox"/> Submersible <input type="checkbox"/> Turbine <input type="checkbox"/> Jet <input type="checkbox"/> Reciprocating <input type="checkbox"/> Centrifugal <input type="checkbox"/> Other	
		<b>Grey Clay</b>		<b>90</b>	<b>103</b>	16 Remarks: elevation <b>450</b> Topography: <input checked="" type="checkbox"/> Hill <input type="checkbox"/> Slope <input type="checkbox"/> Upland <input type="checkbox"/> Valley	
		(use a second sheet if needed)				17 Water well contractor's certification: This well was drilled under my jurisdiction and this report is true to the best of my knowledge and belief. <b>Strader Drilling Co. Inc 192</b> Business name License No. Address <b>RFD 1 Holton, KS 66436</b> Signed <b>Dale Ashburn</b> Date <b>6-</b> Authorized representative	

LET MEAS 11-1-1977