


1 LOCATION OF WATER WELL: County: JACKSON	Fraction NE 1/4 NE 1/4 SE 1/4	Section Number 29	Township Number T 6 S	Range Number R 14 E/W
--	----------------------------------	----------------------	--------------------------	--------------------------

Distance and direction from nearest town or city street address of well if located within city?
1/2 west, 5/8 south of Circleville

2 WATER WELL OWNER: Lester Shupe
RR#, St. Address, Box # : 25161 J. Road Board of Agriculture, Division of Water Resources
City, State, ZIP Code : Circleville, KS 66416 Application Number:

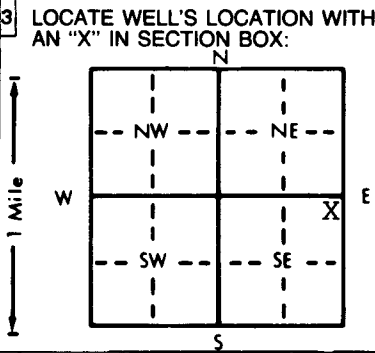

4 DEPTH OF COMPLETED WELL... 52' ft. ELEVATION: ...

Depth(s) Groundwater Encountered 1. ft. 2. ft. 3. ft.

WELL'S STATIC WATER LEVEL ... 11' ft. below land surface measured on mo/day/yr ... 1-10-94.

Pump test data: Well water was ft. after hours pumping gpm

Est. Yield .. 75. gpm: Well water was ft. after hours pumping gpm

Bore Hole Diameter. 12" in. to ft., and in. to ft.

WELL WATER TO BE USED AS:

5 Public water supply	8 Air conditioning	11 Injection well
1 Domestic	3 Feedlot	6 Oil field water supply
2 Irrigation	4 Industrial	7 Lawn and garden only
		9 Dewatering
		10 Monitoring well
		12 Other (Specify below)

Was a chemical/bacteriological sample submitted to Department? Yes.....No.....X.....; If yes, mo/day/yr sample was submitted

Water Well Disinfected? Yes X No

5 TYPE OF BLANK CASING USED:

1 Steel	3 RMP (SR)	5 Wrought iron	8 Concrete tile	CASING JOINTS: Glued . X . . . Clamped
+ 2 PVC	4 ABS	6 Asbestos-Cement	9 Other (specify below)	Welded
		7 Fiberglass		Threaded

Blank casing diameter 5" in. to 0-12' ft., Dia in. to ft., Dia in. to ft.

Casing height above land surface 24" in., weight 2.82 lbs./ft. Wall thickness or gauge No. 258

TYPE OF SCREEN OR PERFORATION MATERIAL:

1 Steel	3 Stainless steel	5 Fiberglass	7 PVC	10 Asbestos-cement
2 Brass	4 Galvanized steel	6 Concrete tile	8 RMP (SR)	11 Other (specify)
			9 ABS	12 None used (open hole)

SCREEN OR PERFORATION OPENINGS ARE:

1 Continuous slot	3 Mill slot	5 Gauzed wrapped	8 Saw cut	11 None (open hole)
2 Louvered shutter	4 Key punched	6 Wire wrapped	9 Drilled holes	
		7 Torch cut	10 Other (specify)	

SCREEN-PERFORATED INTERVALS: From 12' ft. to 52' ft., From ft. to ft.

GRAVEL PACK INTERVALS: From 11' ft. to 52' ft., From ft. to ft.

6 GROUT MATERIAL: 1 Neat cement 2 Cement grout 3 Bentonite 4 Other

Grout intervals: From 0' ft. to 11' ft., From ft. to ft., From ft. to ft.

What is the nearest source of possible contamination:

1 Septic tank	4 Lateral lines	7 Pit privy	10 Livestock pens	14 Abandoned water well
2 Sewer lines	5 Cess pool	8 Sewage lagoon	11 Fuel storage	15 Oil well/Gas well
3 Watertight sewer lines	6 Seepage pit	9 Feedyard	12 Fertilizer storage	16 Other (specify below)
			13 Insecticide storage creek

Direction from well? south How many feet? 75'

FROM	TO	LITHOLOGIC LOG	FROM	TO	PLUGGING INTERVALS
0	4	Top Soil			
4	12	Clay-Brown			
12	24	Fine Sand-Brown			
24-28		Clay-Blue			
28	45	Fine Sand-Coarse Sand-Med-Pea Gravel-Brown-Grey			
45	52	Fine Sand-Coarse Sand-MEd-Pea Gravel-Dirty			
52	58	Clay-Blue			
58	60	Fine Sand-Coarse Sand-Med-Pea, Black-Green			

NOTE: 1-21-94 Permission to shallow grout from Richard Harper

7 CONTRACTOR'S OR LANDOWNER'S CERTIFICATION: This water well was (1) constructed, (2) reconstructed, or (3) plugged under my jurisdiction and was completed on (mo/day/year) 1-10-94 and this record is true to the best of my knowledge and belief. Kansas Water Well Contractor's License No. 182 This Water Well Record was completed on (mo/day/yr) 2-14-94 under the business name of STRADER DRILLING CO., INC. by (signature) Dale Harper