

1 LOCATION OF WATER WELL:	Fraction	Section Number	Township Number	Range Number
County: JACKSON	SW 1/4 SW 1/4 NW 1/4	36	T 6 S	R 14 E/W


Distance and direction from nearest town or city street address of well if located within city?

3 west, 1 1/2 north of Holton

2 WATER WELL OWNER: Dave King
 RR#, St. Address, Box # : 721 Colorado
 City, State, ZIP Code : Holton, KS 66436
 Board of Agriculture, Division of Water Resources
 Application Number:

3 LOCATE WELL'S LOCATION WITH AN "X" IN SECTION BOX:

4 DEPTH OF COMPLETED WELL: 100 ft. ELEVATION:

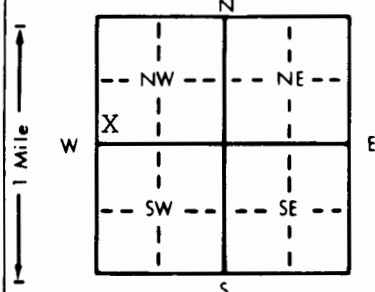

Depth(s) Groundwater Encountered 1. 16' ft. 2. ft. 3. ft.
 WELL'S STATIC WATER LEVEL 4' ft. below land surface measured on mo/day/yr 8-23-90
 Pump test data: Well water was ft. after hours pumping gpm
 Est. Yield 3 gpm: Well water was ft. after hours pumping gpm
 Bore Hole Diameter 8 3/4 in. to ft., and in. to ft.
 WELL WATER TO BE USED AS:
 5 Public water supply 8 Air conditioning 11 Injection well
 1 Domestic 3 Feedlot 6 Oil field water supply 9 Dewatering 12 Other (Specify below)
 2 Irrigation 4 Industrial 7 Lawn and garden only 10 Monitoring well
 Was a chemical/bacteriological sample submitted to Department? Yes No ; If yes, mo/day/yr sample was submitted
 Water Well Disinfected? Yes No

5 TYPE OF BLANK CASING USED:
 1 Steel 3 RMP (SR) 5 Wrought iron 8 Concrete tile CASING JOINTS: Glued Clamped
 2 PVC 4 ABS 6 Asbestos-Cement 9 Other (specify below) Welded
 7 Fiberglass Threaded

Blank casing diameter 5" in. to 0-15 ft., Dia 5" in. to 25-98 ft., Dia in. to ft.
 Casing height above land surface 24" in., weight 2.82 lbs./ft. Wall thickness or gauge No. 258

TYPE OF SCREEN OR PERFORATION MATERIAL:
 1 Steel 3 Stainless steel 5 Fiberglass 7 PVC 10 Asbestos-cement
 2 Brass 4 Galvanized steel 6 Concrete tile 8 RMP (SR) 11 Other (specify)
 12 None used (open hole)

SCREEN OR PERFORATION OPENINGS ARE:
 1 Continuous slot 3 Mill slot 5 Gauzed wrapped 8 Saw cut 11 None (open hole)
 2 Louvered shutter 4 Key punched 6 Wire wrapped 9 Drilled holes
 7 Torch cut 10 Other (specify)

SCREEN-PERFORATED INTERVALS: From 15 ft. to 25 ft., From ft. to ft.
 From 98 ft. to 100 ft., From ft. to ft.
 GRAVEL PACK INTERVALS: From 13 ft. to 100 ft., From ft. to ft.
 From ft. to ft., From ft. to ft.

6 GROUT MATERIAL: 1 Neat cement 2 Cement grout 3 Bentonite 4 Other hole plug
 Grout Intervals: From 0 ft. to 13 ft., From ft. to ft., From ft. to ft.

What is the nearest source of possible contamination:
 1 Septic tank 4 Lateral lines 7 Pit privy 10 Livestock pens 14 Abandoned water well
 2 Sewer lines 5 Cess pool 8 Sewage lagoon 11 Fuel storage 15 Oil well/Gas well
 3 Watertight sewer lines 6 Seepage pit 9 Feedyard 12 Fertilizer storage 16 Other (specify below)
 13 Insecticide storage
 Direction from well? East How many feet? 1100'

FROM	TO	LITHOLOGIC LOG	FROM	TO	PLUGGING INTERVALS
0	26	Clay-Brown			
26	55	Clay-Blue			
55	59	Shale-Yellow			Note: 9-26-90 Permission from D. Taylor to grout @ 13'
59	67	Shale-Grey			
67	78	Limestone-Grey			
78	81	Shale-Red			
81	84	Shale-Grey			
84	90	Shale-Red			
90	93	Limestone-Grey			
93	100	Shale-Grey			

7 CONTRACTOR'S OR LANDOWNER'S CERTIFICATION: This water well was (1) constructed, (2) reconstructed, or (3) plugged under my jurisdiction and was completed on (mo/day/year) 8-2-90 and this record is true to the best of my knowledge and belief. Kansas Water Well Contractor's License No. 182 This Water Well Record was completed on (mo/day/yr) 10-22-90 under the business name of STRADER DRILLING CO., INC. by (signature) Dale Skren