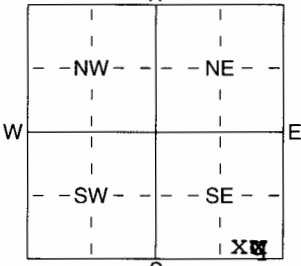


1 LOCATION OF WATER WELL: County: <b>Jackson</b>	Fraction <b>SW 1/4 SE 1/4 SE 1/4</b>	Section Number <b>22</b>	Township Number <b>T 6 S</b>	Range Number <b>R 14E E/W</b>
---	---	-----------------------------	---------------------------------	----------------------------------

Distance and direction from nearest town or city street address of well if located within city?

**3/4 imles east of Circleville**

2 WATER WELL OWNER: **Ed Kathrens**  
 RR#, St. Address, Box # : **8668 254th Rd**  
 City, State, ZIP Code : **Circleville, Ks. 66416**  
 Board of Agriculture, Division of Water Resources  
 Application Number:

3 LOCATE WELL'S LOCATION WITH AN "X" IN SECTION BOX: 	4 DEPTH OF COMPLETED WELL ..... <b>60</b> ..... ft. ELEVATION: .....
--	--

Depth(s) Groundwater Encountered 1 ..... ft. 2 ..... ft. 3 ..... ft.  
 WELL'S STATIC WATER LEVEL .....**11**..... ft. below land surface measured on mo/day/yr .....**2-24-05**.....  
 Pump test data: Well water was ..... ft. after ..... hours pumping ..... gpm  
 Est. Yield .....**1.0**..... gpm: Well water was ..... ft. after ..... hours pumping ..... gpm  
 WELL WATER TO BE USED AS: 5 Public water supply 8 Air conditioning 11 Injection well  
 1 Domestic 3 Feedlot 6 Oil field water supply 9 Dewatering 12 Other (Specify below)  
 2 Irrigation 4 Industrial 7 Domestic (lawn & garden) 10 Monitoring well **livestock**

Was a chemical/bacteriological sample submitted to Department? Yes ..... No **X**.....; If yes, mo/day/yrs sample was submitted  
 Water Well Disinfected? Yes **X** No

5 TYPE OF BLANK CASING USED:  
 1 Steel 3 RMP (SR) 5 Wrought iron 8 Concrete tile CASING JOINTS: Glued **X** Clamped .....  
 2 PVC 4 ABS 6 Asbestos-Cement 9 Other (specify below) Welded .....  
 7 Fiberglass Threaded .....

Blank casing diameter ..... **5** ..... in. to ..... ft., Dia ..... in. to ..... ft., Dia ..... in. to ..... ft.  
 Casing height above land surface ..... **24** ..... in., weight ..... **2.82** ..... lbs./ft. Wall thickness or gauge No. **.258**

TYPE OF SCREEN OR PERFORATION MATERIAL:  
 1 Steel 3 Stainless Steel 5 Fiberglass 7 PVC 10 Asbestos-Cement  
 2 Brass 4 Galvanized Steel 6 Concrete tile 9 ABS 11 Other (Specify) .....  
 12 None used (open hole)

SCREEN OR PERFORATION OPENINGS ARE:  
 1 Continuous slot 3 Mill slot 5 Gauzed wrapped 8 Saw cut 11 None (open hole)  
 2 Louvered shutter 4 Key punched 6 Wire wrapped 9 Drilled holes  
 7 Torch cut 10 Other (specify) .....

SCREEN-PERFORATED INTERVALS: From ..... **22** ..... ft. to ..... **42** ..... ft., From ..... ft. to ..... ft.  
 GRAVEL PACK INTERVALS: From ..... **22** ..... ft. to ..... **60** ..... ft., From ..... ft. to ..... ft.

6 GROUT MATERIAL: 1 Neat cement 2 Cement grout 3 Bentonite 4 Other .....

Grout intervals: From ..... **1** ..... ft. to ..... **22** ..... ft., From ..... ft. to ..... ft., From ..... ft. to ..... ft.

What is the nearest source of possible contamination:  
 1 Septic tank 4 Lateral lines 7 Pit privy 10 Livestock pens 14 Abandoned water well  
 2 Sewer lines 5 Cess pool 8 Sewage lagoon 11 Fuel storage 15 Oil well/Gas well  
 3 Watertight sewer lines 6 Seepage pit 9 Feedyard 12 Fertilizer storage 16 Other (specify below)  
 13 Insecticide storage **creek**

Direction from well? **west** How many feet? **110'**

FROM	TO	LITHOLOGIC LOG	FROM	TO	PLUGGING INTERVALS
0	4	top soil			
4	27	clay brown			
27	29	clay grey			
29	32	limestone yellow loose			
32	51	shale & blue grey			
51	60	shale grey			
<del>60</del>					

7 CONTRACTOR'S OR LANDOWNER'S CERTIFICATION: This water well was (1) constructed, (2) reconstructed, or (3) plugged under my jurisdiction and was completed on (mo/day/year) ..... **2-24-05** ..... and this record is true to the best of my knowledge and belief. Kansas Water Well Contractor's Licence No ..... **182** ..... This Water Well Record was completed on (mo/day/yr) ..... **4-4-05** ..... under the business name of **Strader Drilling Co., Inc.** by (signature) *Jim Strader*