


**WATER WELL RECORD Form WWC-5 KSA 82a-1212**

1 LOCATION OF WATER WELL:  
 County: JACKSON      Fraction SE ¼ SW ¼ SW ¼      Section Number 21      Township Number T 6 S      Range Number R 14 EW  
 Distance and direction from nearest town or city street address of well if located within city?  
 201 LINCOLN STREET (MW-8)

2 WATER WELL OWNER: WYKEST GROCERY  
 RR#, St. Address, Box # : 201 LINCOLN STREET  
 City, State, ZIP Code : CIRCLEVILLE, KANSAS 66416  
 Board of Agriculture, Division of Water Resources  
 Application Number:

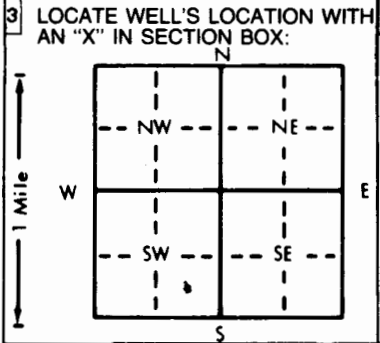

4 DEPTH OF COMPLETED WELL 35 ft. ELEVATION: 1126.2  
 Depth(s) Groundwater Encountered 1. 25 ft. 2. 24.65 ft. 3.      ft.  
 WELL'S STATIC WATER LEVEL 24.65 ft. below land surface measured on mo/day/yr 4/2/97  
 Pump test data: Well water was      ft. after      hours pumping      gpm  
 Est. Yield      gpm: Well water was      ft. after      hours pumping      gpm  
 Bore Hole Diameter 8.25 in. to 35      ft., and      in. to      ft.  
 WELL WATER TO BE USED AS: 5 Public water supply 8 Air conditioning 11 Injection well  
 1 Domestic 3 Feedlot 6 Oil field water supply 9 Dewatering 12 Other (Specify below)  
 2 Irrigation 4 Industrial 7 Lawn and garden only 10 Monitoring well  
 Was a chemical/bacteriological sample submitted to Department? Yes      No      If yes, mo/day/yr sample was sub-  
 mitted      Water Well Disinfected? Yes      No

5 TYPE OF BLANK CASING USED:  
 1 Steel      3 RMP (SR)  
 2 PVC      4 ABS  
 5 Wrought iron      8 Concrete tile      CASING JOINTS: Glued      Clamped  
 6 Asbestos-Cement      9 Other (specify below)      Welded  
 7 Fiberglass                Threaded. X  
 Blank casing diameter      in. to      ft., Dia      in. to      ft., Dia      in. to      ft.  
 Casing height above land surface      in., weight      lbs./ft. Wall thickness or gauge No.        
 TYPE OF SCREEN OR PERFORATION MATERIAL:  
 1 Steel      3 Stainless steel      5 Fiberglass      8 RMP (SR)  
 2 Brass      4 Galvanized steel      6 Concrete tile      9 ABS      10 Asbestos-cement  
 11 Other (specify)      12 None used (open hole)  
 SCREEN OR PERFORATION OPENINGS ARE:  
 1 Continuous slot      3 Mill slot      5 Gauzed wrapped      8 Saw cut      11 None (open hole)  
 2 Louvered shutter      4 Key punched      6 Wire wrapped      9 Drilled holes  
 7 Torch cut      10 Other (specify)        
 SCREEN-PERFORATED INTERVALS: From 20 ft. to 35 ft.      From      ft. to      ft.  
 From      ft. to      ft.      From      ft. to      ft.  
 GRAVEL PACK INTERVALS: From 18 ft. to 35 ft.      From      ft. to      ft.  
 From      ft. to      ft.      From      ft. to      ft.

6 GROUT MATERIAL: 1 Neat cement      2 Cement grout      3 Bentonite      4 Other  
 Grout intervals: From 0 ft. to 16 ft.      From 16 ft. to 18 ft.      From      ft. to      ft.  
 What is the nearest source of possible contamination:  
 1 Septic tank      4 Lateral lines      7 Pit privy      10 Livestock pens      14 Abandoned water well  
 2 Sewer lines      5 Cess pool      8 Sewage lagoon      11 Fuel storage      15 Oil well/Gas well  
 3 Watertight sewer lines      6 Seepage pit      9 Feedyard      12 Fertilizer storage      16 Other (specify below)  
 13 Insecticide storage        
 Direction from well?      How many feet?

FROM	TO	LITHOLOGIC LOG	FROM	TO	PLUGGING INTERVALS
0	1	FILL			
1	25	SAND SILTY CLAY			
25	34	SAND			
34	35	SILTY CLAY			

7 CONTRACTOR'S OR LANDOWNER'S CERTIFICATION: This water well was (1) constructed, (2) reconstructed, or (3) plugged under my jurisdiction and was completed on (mo/day/year) 4-2-97 and this record is true to the best of my knowledge and belief. Kansas Water Well Contractor's License No. 575 This Water Well Record was completed on (mo/day/yr) 7-10-97 under the business name of KURTZ ENVIRONMENTAL SERVICE by (signature)

INSTRUCTIONS: Use typewriter or ball point pen. PLEASE PRESS FIRMLY and PRINT clearly. Please fill in blanks, underline or circle the correct answers. Send two copies to Kansas Department of Health and Environment, Bureau of Water, Topeka, Kansas 66620-0001. Telephone: 913-296-5545. Send one to WATER WELL OWNER and retain one for your records.

OFFICE USE ONLY

T

R

EW

SEC.

1/4

1/4