


1 LOCATION OF WATER WELL:	Fraction	Section Number	Township Number	Range Number
County: JACKSON	NW 1/4 SW 1/4 NW 1/4	34	T 6S S	R 15E EW

Distance and direction from nearest town or city street address of well if located within city?
1 mile north of Holton

2 WATER WELL OWNER: Don Tanking
 RR#, St. Address, Box # : 24428 Q Rd. Board of Agriculture, Division of Water Resources
 City, State, ZIP Code : Holton, KS 66436 Application Number:

3 LOCATE WELL'S LOCATION WITH AN "X" IN SECTION BOX:

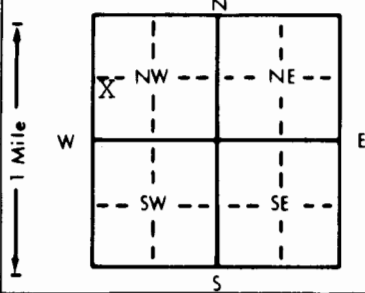

4 DEPTH OF COMPLETED WELL: 50' ft. ELEVATION:

Depth(s) Groundwater Encountered 1. 14' ft. 2. ft. 3. ft.

WELL'S STATIC WATER LEVEL . 11' ft. below land surface measured on mo/day/yr 8/08/97

Pump test data: Well water was ft. after hours pumping gpm

Est. Yield . 13 gpm: Well water was ft. after hours pumping gpm

Bore Hole Diameter . 12" in. to ft., and in. to ft.

WELL WATER TO BE USED AS:

5 Public water supply	8 Air conditioning	11 Injection well
1 Domestic	3 Feedlot	6 Oil field water supply
2 Irrigation	4 Industrial	7 Lawn and garden only
		9 Dewatering
		10 Monitoring well
		12 Other (Specify below)

Was a chemical/bacteriological sample submitted to Department? Yes No ; If yes, mo/day/yr sample was submitted

Water Well Disinfected? Yes No

5 TYPE OF BLANK CASING USED:

1 Steel	3 RMP (SR)	5 Wrought iron	8 Concrete tile	CASING JOINTS: Glued Clamped
2 PVC	4 ABS	6 Asbestos-Cement	9 Other (specify below)	Welded
		7 Fiberglass		Threaded

Blank casing diameter 5" in. to 0-12 ft., Dia 5" in. to 32-49 ft., Dia in. to ft.

Casing height above land surface 24" in., weight 2.82 lbs./ft. Wall thickness or gauge No. 258

TYPE OF SCREEN OR PERFORATION MATERIAL:

1 Steel	3 Stainless steel	5 Fiberglass	7 PVC	10 Asbestos-cement
2 Brass	4 Galvanized steel	6 Concrete tile	8 RMP (SR)	11 Other (specify)
			9 ABS	12 None used (open hole)

SCREEN OR PERFORATION OPENINGS ARE:

1 Continuous slot	3 Mill slot	5 Gauzed wrapped	8 Saw cut	11 None (open hole)
2 Louvered shutter	4 Key punched	6 Wire wrapped	9 Drilled holes	
		7 Torch cut	10 Other (specify)	

SCREEN-PERFORATED INTERVALS: From 12 ft. to 32 ft., From ft. to ft.

From 49 ft. to 50 ft., From ft. to ft.

GRAVEL PACK INTERVALS: From 11 ft. to 50 ft., From ft. to ft.

From ft. to ft., From ft. to ft.

6 GROUT MATERIAL: 1 Neat cement 2 Cement grout 3 Bentonite 4 Other

Grout Intervals: From 0 ft. to 11 ft., From ft. to ft., From ft. to ft.

What is the nearest source of possible contamination:

1 Septic tank	4 Lateral lines	7 Pit privy	10 Livestock pens	14 Abandoned water well
2 Sewer lines	5 Cess pool	8 Sewage lagoon	11 Fuel storage	15 Oil well/Gas well
3 Watertight sewer lines	6 Seepage pit	9 Feedyard	12 Fertilizer storage	16 Other (specify below)
			13 Insecticide storage	

Direction from well? NORTH

How many feet? 250'

FROM	TO	LITHOLOGIC LOG	FROM	TO	PLUGGING INTERVALS
0	10	Clay-Brown			
10	18	Fine Sand-Brown			
18	26	Clay-Brown			8/29/97 NOTE: Permission to shallow grout from Don Taylor
26	28	Fine Sand-Brown			
28	31	Fine Sand-Coarse Sand-Med Gravel-Brown			
31	32	Clay-Brown			
32	48	Clay-Blue			
48	50	Shale-Grey			

7 CONTRACTOR'S OR LANDOWNER'S CERTIFICATION: This water well was (1) constructed, (2) reconstructed, or (3) plugged under my jurisdiction and was completed on (mo/day/year) 8/29/97 and this record is true to the best of my knowledge and belief. Kansas Water Well Contractor's License No. 182 This Water Well Record was completed on (mo/day/yr) 9-29-97 under the business name of STRADER DRILLING CO., INC. by (signature) Dale Skren

INSTRUCTIONS: Use typewriter or ball point pen. PLEASE PRESS FIRMLY and PRINT clearly. Please fill in blanks, underline or circle the correct answers. Send top three copies to Kansas Department of Health and Environment, Bureau of Water, Topeka, Kansas 66620-0001. Telephone: 913-296-5545. Send one to WATER WELL OWNER and retain one for your records.

OFFICE USE ONLY T R EW SEC