USE TYPEWRITER OR BALL POINT PEN-PRESS FIRMLY, PRINT CLEARLY.

WATER WELL RECORD
KSA 82a-1201-1215

Kansas Department of Health and Environment-Division of Environment
(Water well Contractors)
Topeka, Kansas 66620

1. Location of well:	County: Jackson	Fraction: SW 1/4 SW 1/4 SE 1/4	Section number: 6	Township number: T 6 (S)	Range number: R 15 (E/W)

2. Distance and direction from nearest town or city: 6 miles North of Holton on new Hwy. 75 and 2½ miles west on dirt road.
Street address of well location if in city:

3. Owner of well: Bruce L. Clements
R. or street: Rt. 3
City, state, zip code: Holton, Ks. 66436

4. Locate with "X" in section below:

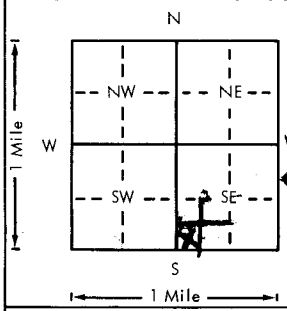

Sketch map:

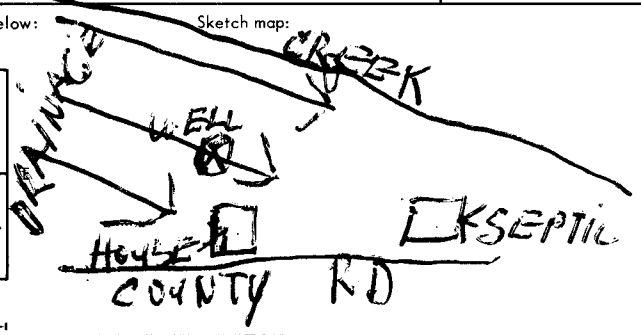

6. Bore hole dia. 42 in. Completion date 9-30-83
Well depth 30 ft. Bore hole 50" to 11 ft.

7. __ Cable tool __ Rotary __ Driven __ Dug
__ Hollow rod __ Jetted X Bored __ Reverse rotary

8. Use: X Domestic __ Public supply __ Industry
__ Irrigation __ Air conditioning __ Stock
__ Lawn __ Oil field water __ Other

9. Casing: Material Concrete (Weight above or below)
Threaded ___ Welded ___ Surface 36 in.
RMP ___ PVC ___ Weight 320 lbs./ft.
Dia. ___ in. to ___ ft. depth Wall Thickness: inches or
Dia. ___ in. to ___ ft. depth gage No. 3"

5. Type and color of material		From	To
Black silty topsoil		0	4
Blue-gray silty clay	03	4	12
Yellow -brown clay - hard		12	16
Same - fairly soft	01	16	21
Coarse brown sand - very ~~productive~~ productive	09	21	24
Egg size gravel - gets larger near 29 ft. VERY PRODUCTING	15	24	29
Hard blue clay - near shale	01	29	30

(Use a second sheet if needed)

10. Screen: Manufacturer's name ___
Type ___ Dia. ___
Slot/gauze ___ Length ___
Set between ___ ft. and ___ ft.
___ ft. and ___ ft.
Gravel pack? ___ Size range of material ___

11. Static water level: mo./day/yr.
15 ft. below land surface Date 9-29-83

12. Pumping level below land surfaces:
17 ft. after 1 hrs. pumping 10 g.p.m.
19 ft. after 2 hrs. pumping 10 g.p.m.
Estimated maximum yield 7 g.p.m.

13. Water sample submitted: mo./day/yr.
___ Yes X No Date ___

14. Well head completion:
___ Pitless adapter ___ Inches above grade

15. Well grouted? XX
With: X Neat cement ___ Bentonite ___ Concrete
Depth: From 0 ft. to 11 ft.

16. Nearest source of possible contamination:
ft. 300 Direction Southeast Type Septic
Well disinfected upon completion? X Yes ___ No

17. Pump: XX Not installed
Manufacturer's name ___
Model number ___ HP ___ Volts ___
Length of drop pipe ___ ft. capacity ___ g.p.m.
Type:
___ Submersible ___ Turbine
___ Jet ___ Reciprocating
___ Centrifugal ___ Other

T 06 R 15 W Sec 06 1/4 SW 1/4 SW 1/4 SE 1/4

18. Elevation:

Topography:
___ Hill
___ Slope
___ Upland
X Valley

19. Remarks:

20. Water well contractor's certification:
This well was drilled under my jurisdiction and this report is true to the best of my knowledge and belief.
Popplewell Well Boring 320
Business name License No.
Address Amity, Mo. 64422
Signed [signature] Date 10-21-83
Authorized representative

Forward the white, blue and pink copies to the Department of Health and Environment

Form WWC-5

D

MI-1023