

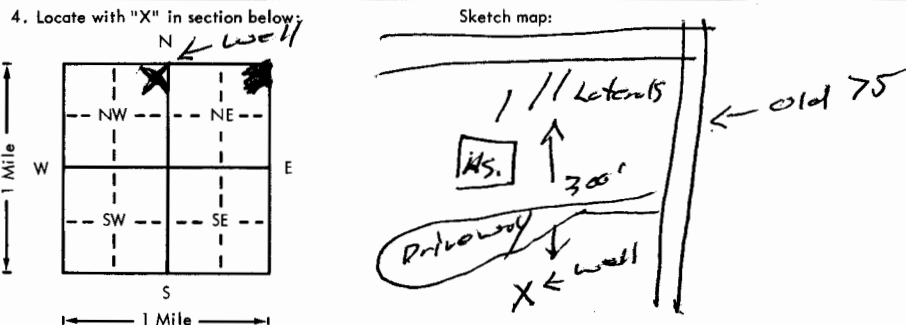
45

USE TYPEWRITER OR BALL POINT PEN-PRESS FIRMLY, PRINT CLEARLY.

WATER WELL RECORD
KSA 82a-1201-1215

Kansas Department of Health and Environment-Division of Environment
(Water well Contractors)
Topeka, Kansas 66620

baa

1. Location of well: County <u>Jackson</u> Fraction <u>NE 1/4 NE 1/4 NW 1/4</u> Section number <u>27</u> Township number <u>T 6 S R 15</u> Range number <u>15</u> E/W	
2. Distance and direction from nearest town or city: <u>3 N</u> Street address of well location if in city: <u>Holtton</u>	
3. Owner of well: <u>Marlin Zebell</u> R.R. or street: <u>RR #3</u> City, state, zip code: <u>Holtton, Ks. 66426</u>	
4. Locate with "X" in section below: 	
6. Bore hole dia. <u>8</u> in. Completion date <u>8-23-77</u> Well depth <u>100</u> ft.	
7. <input checked="" type="checkbox"/> Cable tool <input checked="" type="checkbox"/> Rotary <input type="checkbox"/> Driven <input type="checkbox"/> Dug <input type="checkbox"/> Hollow rod <input type="checkbox"/> Jetted <input type="checkbox"/> Bored <input type="checkbox"/> Reverse rotary	
8. Use: <input checked="" type="checkbox"/> Domestic <input type="checkbox"/> Public supply <input type="checkbox"/> Industry <input type="checkbox"/> Irrigation <input type="checkbox"/> Air conditioning <input type="checkbox"/> Stock <input type="checkbox"/> Lawn <input type="checkbox"/> Oil field water <input type="checkbox"/> Other	
9. Casing: Material <u>PVC</u> Height: <u>Above</u> or below Threaded <input type="checkbox"/> Welded <input type="checkbox"/> Surface <u>24</u> in. RMP <input type="checkbox"/> PV <u>Blue</u> Weight <u>2.74</u> lbs./ft. Dia. <u>5</u> in. to <u>100</u> ft. depth Wall Thickness: inches or Dia. <input type="checkbox"/> in. to <input type="checkbox"/> ft. depth gage No. <u>258</u>	
10. Screen: Manufacturer's name <u>Kumpco</u> Type <u>PVC</u> Dia. <u>5"</u> Slot/gauze <u>080</u> Length <u>10'</u> Set between <u>90</u> ft. and <u>100</u> ft. <input type="checkbox"/> Gravel pack? <input checked="" type="checkbox"/> Size range of material <u>1/4 x 1/8</u>	
11. Static water level: <u>5</u> mo./day/yr. <u>50</u> ft. below land surface Date <u>8-23-77</u>	
12. Pumping level below land surfaces: <u>Air test</u> <input type="checkbox"/> ft. after <input type="checkbox"/> hrs. pumping <input type="checkbox"/> g.p.m. <input type="checkbox"/> ft. after <input type="checkbox"/> hrs. pumping <input type="checkbox"/> g.p.m. Estimated maximum yield <u>70</u> g.p.m.	
13. Water sample submitted: <input type="checkbox"/> Yes <input checked="" type="checkbox"/> No Date <input type="checkbox"/> mo./day/yr.	
14. Well head completion: <u>Top cap</u> <input type="checkbox"/> Pitless adapter <u>24</u> inches above grade	
15. Well grouted? <input checked="" type="checkbox"/> With: <input checked="" type="checkbox"/> Neat cement <input type="checkbox"/> Bentonite <input type="checkbox"/> Concrete Depth: From <u>0</u> ft. to <u>10</u> ft.	
16. Nearest source of possible contamination: ft. <u>300</u> Direction <u>N</u> Type <u>Lot 15</u> Well disinfected upon completion? <input checked="" type="checkbox"/> Yes <input type="checkbox"/> No	
17. Pump: <input checked="" type="checkbox"/> Not installed Manufacturer's name <u>Jacuzzi</u> Model number <u>5548</u> HP <u>1/2</u> Volt <u>230</u> Length of drop pipe <u>90</u> ft. capacity <u>10</u> g.p.m. Type: <input checked="" type="checkbox"/> Submersible <input type="checkbox"/> Turbine <input type="checkbox"/> Jet <input type="checkbox"/> Reciprocating <input type="checkbox"/> Centrifugal <input type="checkbox"/> Other	
(Use a second sheet if needed)	
18. Elevation: <u>1124</u> Topography: <input type="checkbox"/> Hill <input type="checkbox"/> Slope <input checked="" type="checkbox"/> Upland <input type="checkbox"/> Valley	19. Remarks: <u>owner will construct cement slab around well</u>
20. Water well contractor's certification: This well was drilled under my jurisdiction and this report is true to the best of my knowledge and belief. <u>Stader Only to Stone 182</u> Business name <u>PTI Holtton, Ks</u> License No. <u>52517</u> Address <u>PTI Holtton, Ks</u> Signed <u>Dale Stader</u> Date <u>8-25-77</u> Authorized representative	

T 6 S R 15 E/W
1/4 1/4 1/4 1/4
NE NE NE NE