9

USE TYPEWRITER OR BALL POINT PEN-PRESS FIRMLY, PRINT CLEARLY.

WATER WELL RECORD
KSA 82a-1201-1215

acc

Kansas Department of Health and Environment-Division of Environment
(Water well Contractors)
Topeka, Kansas 66620

1. Location of well:	County	Fraction	Section number	Township number	Range number
	JACKSON	NE 1/4 NE 1/4 NE 1/4	27	T 6 S	R 15 E W

2. Distance and direction from nearest town or city: 2.5 N OF
Street address of well location if in city: HOLTON

3. Owner of well: DALE BUSS
R.R. or street: RR 1
City, state, zip code: HOLTON, KS

4. Locate with "X" in section below:

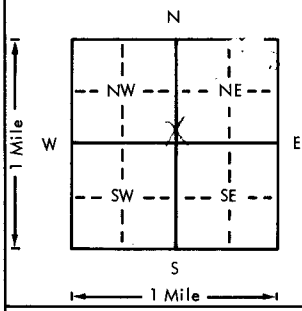

Sketch map:

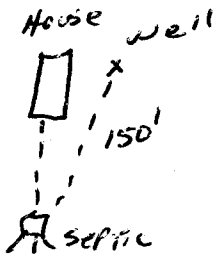

6. Bore hole dia. 12 in. Completion date
Well depth 95 ft. 5-31-77

7. Cable tool ✓ Rotary Driven Dug
Hollow rod Jetted Bored Reverse rotary

8. Use: ✓ Domestic Public supply Industry
Irrigation Air conditioning Stock
Lawn Oil field water Other

9. Casing: Material PVC Height: Above or below
Threaded Welded Surface 29 in.
RMP PVC 96 Weight 2.50 lbs./ft.
Dia. 5 in. to 95 ft. depth Wall Thickness: inches or
Dia. in. to ft. depth gage No. [redacted] 258

5. Type and color of material	From	To
Top Soil	0	5
Clay, yellow	5	46
Course Sand	46	50
Blue Clay	50	95

(Use a second sheet if needed)

10. Screen: Manufacturer's name PUMPCO
Type PVC Dia. 5
Slot/gauze .020 Length 10
Set between 45 ft. and 55 ft.
ft. and ft.
Gravel pack? ✓ Size range of material .030X.060

11. Static water level: mo./day/yr.
40 ft. below land surface Date 5-31-77

12. Pumping level below land surfaces:
ft. after hrs. pumping g.p.m.
ft. after hrs. pumping g.p.m.
Estimated maximum yield 5 g.p.m.

13. Water sample submitted: mo./day/yr.
Yes ✓ No Date

14. Well head completion: CAP
Pitless adapter 29 Inches above grade

15. Well grouted? ✓
With: ✓ Neat cement Bentonite Concrete
Depth: From 0 ft. to 10 ft.

16. Nearest source of possible contamination:
ft. 150 Direction S Type SEPTIC
Well disinfected upon completion? ✓ Yes No

17. Pump: Not installed
Manufacturer's name JACUZZI
Model number 554B HP 1/2 Volts 230
Length of drop pipe 20 ft. capacity 0 g.p.m.
Type:
✓ Submersible Turbine
Jet Reciprocating
Centrifugal Other

18. Elevation: 1095
Topography:
✓ Hill
Slope
Upland
Valley

19. Remarks:
OWNER TO INSTAL SLAB

20. Water well contractor's certification:
This well was drilled under my jurisdiction and this report is true to the best of my knowledge and belief.
STRADER DRLG CO INC 182
Business name License No.
Address RT 1 HOLTON, KS
Signed Dale Buss Date 6-2-77
Authorized representative

T 6 R 15 W Sec 27 1/4 NE 1/4 NE 1/4

Forward the white, blue and pink copies to the Department of Health and Environment

Form WWC-5

MI-1023