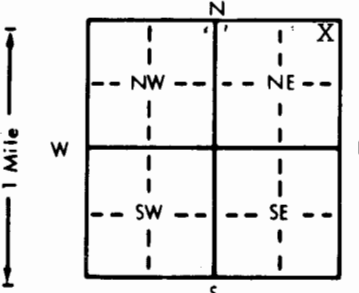


1 LOCATION OF WATER WELL: County: JACKSON	Fraction NE 1/4 NE 1/4 NE 1/4	Section Number 29	Township Number T 6 S	Range Number R 15 EW
----------------------------------------------	----------------------------------	----------------------	--------------------------	-------------------------

Distance and direction from nearest town or city street address of well if located within city?

2 1/2 north, 1/2 west of Holton

2 WATER WELL OWNER: Nick Pool
 RR#, St. Address, Box # : Rt. 3
 City, State, ZIP Code : Holton, KS 66436
 Board of Agriculture, Division of Water Resources
 Application Number:

3 LOCATE WELL'S LOCATION WITH AN "X" IN SECTION BOX:


4 DEPTH OF COMPLETED WELL: 137 ft. ELEVATION:
 Depth(s) Groundwater Encountered 1. 108-111 ft. 2. ft. 3. ft.
 WELL'S STATIC WATER LEVEL .31' ft. below land surface measured on mo/day/yr 2-13-89
 Pump test data: Well water was ft. after hours pumping gpm
 Est. Yield .10 gpm: Well water was ft. after hours pumping gpm
 Bore Hole Diameter 12" in. to ft., and in. to ft.
 WELL WATER TO BE USED AS:
 1 Domestic 3 Feedlot 6 Oil field water supply 9 Dewatering 12 Other (Specify below)
 2 Irrigation 4 Industrial 7 Lawn and garden only 10 Monitoring well
 Was a chemical/bacteriological sample submitted to Department? Yes X No; If yes, mo/day/yr sample was submitted 2-20-89
 Water Well Disinfected? Yes X No

5 TYPE OF BLANK CASING USED:
 1 Steel 3 RMP (SR) 5 Wrought iron 8 Concrete tile CASING JOINTS: Glued X Clamped
 2 PVC 4 ABS 6 Asbestos-Cement 9 Other (specify below) Welded
 7 Fiberglass Threaded
 Blank casing diameter 5" in. to 0-107 ft., Dia 5" in. to 117-137 ft., Dia in. to ft.
 Casing height above land surface 24" in., weight 2.82 lbs./ft. Wall thickness or gauge No. 258
 TYPE OF SCREEN OR PERFORATION MATERIAL:
 1 Steel 3 Stainless steel 5 Fiberglass 8 RMP (SR) 10 Asbestos-cement
 2 Brass 4 Galvanized steel 6 Concrete tile 9 ABS 11 Other (specify)
 12 None used (open hole)
 SCREEN OR PERFORATION OPENINGS ARE:
 1 Continuous slot 3 Mill slot 5 Gauzed wrapped 8 Saw cut 11 None (open hole)
 2 Louvered shutter 4 Key punched 6 Wire wrapped 9 Drilled holes
 7 Torch cut 10 Other (specify)
 SCREEN-PERFORATED INTERVALS: From 107 ft. to 117 ft., From ft. to ft.
 From ft. to ft., From ft. to ft.
 GRAVEL PACK INTERVALS: From 25 ft. to 137 ft., From ft. to ft.
 From ft. to ft., From ft. to ft.

6 GROUT MATERIAL: 1 Neat cement 2 Cement grout 3 Bentonite 4 Other
 Grout Intervals: From 4 ft. to 25 ft., From ft. to ft., From ft. to ft.
 What is the nearest source of possible contamination:
 1 Septic tank 4 Lateral lines 7 Pit privy 10 Livestock pens 14 Abandoned water well
 2 Sewer lines 5 Cess pool 8 Sewage lagoon 11 Fuel storage 15 Oil well/Gas well
 3 Watertight sewer lines 6 Seepage pit 9 Feedyard 12 Fertilizer storage 16 Other (specify below)
 13 Insecticide storage
 Direction from well? NE How many feet? 110

FROM	TO	LITHOLOGIC LOG	FROM	TO	PLUGGING INTERVALS
0	58	Clay-Brown			
58	88	Clay-Blue			
88	90	Fine Sand-Coarse Sand-Blue			
90	108	Clay-Blue			
108	111	Fine Sand-Coarse Sand-Pea Gravel-Blue			
111	113	Limestone-Grey			
113	132	Shale-Grey			
132	135	Limestone-Grey			
135	137	Shale-Grey			

7 CONTRACTOR'S OR LANDOWNER'S CERTIFICATION: This water well was (1) constructed, (2) reconstructed, or (3) plugged under my jurisdiction and was completed on (mo/day/year) 2-13-89 and this record is true to the best of my knowledge and belief. Kansas Water Well Contractor's License No. 182 This Water Well Record was completed on (mo/day/yr) 4-25-89 under the business name of STRADER DRILLING CO., INC. by (signature) *W. H. Strader*

INSTRUCTIONS: Use typewriter or ball point pen. PLEASE PRESS FIRMLY and PRINT clearly. Please fill in blanks, underline or circle the correct answers. Send top three copies to Kansas Department of Health and Environment, Bureau of Water Protection, Topeka, Kansas 66620-7320. Telephone: 913-296-5514. Send one to WATER WELL OWNER and retain one for your records.