


1 LOCATION OF WATER WELL: County: JACKSON	Fraction SE 1/4 SE 1/4 NW 1/4	Section Number 33	Township Number T 6 S	Range Number R 15 E/W
--	----------------------------------	----------------------	--------------------------	--------------------------

Distance and direction from nearest town or city street address of well if located within city?

1 1/2 mile north of Holton

2 WATER WELL OWNER: Rex Whorten
 RR#, St. Address, Box #: Rt. 1
 City, State, ZIP Code: Holton, KS 66436
 Board of Agriculture, Division of Water Resources
 Application Number:

3 LOCATE WELL'S LOCATION WITH AN "X" IN SECTION BOX:

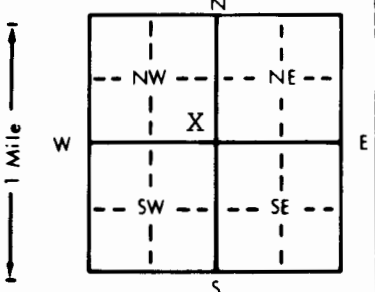

4 DEPTH OF COMPLETED WELL: 48' ft. ELEVATION: ft.
 Depth(s) Groundwater Encountered 1. 27-36' ft. 2. ft. 3. ft.
 WELL'S STATIC WATER LEVEL: 10' ft. below land surface measured on mo/day/yr: 8-6-90
 Pump test data: Well water was ft. after hours pumping gpm
 Est. Yield: 40 gpm; Well water was ft. after hours pumping gpm
 Bore Hole Diameter: 12" in. to ft., and in. to ft.
 WELL WATER TO BE USED AS:
 5 Public water supply 8 Air conditioning 11 Injection well
 1 Domestic 3 Feedlot 6 Oil field water supply 9 Dewatering 12 Other (Specify below)
 2 Irrigation 4 Industrial 7 Lawn and garden only 10 Monitoring well
 Was a chemical/bacteriological sample submitted to Department? Yes..... No X.....; If yes, mo/day/yr sample was submitted
 Water Well Disinfected? Yes X No

5 TYPE OF BLANK CASING USED:
 1 Steel 3 RMP (SR) 5 Wrought iron 8 Concrete tile CASING JOINTS: Glued X Clamped
 2 PVC 4 ABS 6 Asbestos-Cement 9 Other (specify below) Welded
 7 Fiberglass Threaded

Blank casing diameter: 5" in. to 0-23 ft., Dia: 5" in. to 38-48 ft., Dia: in. to ft.
 Casing height above land surface: 24" in., weight: 2.82 lbs./ft. Wall thickness or gauge No.: 258

TYPE OF SCREEN OR PERFORATION MATERIAL:
 1 Steel 3 Stainless steel 5 Fiberglass 7 PVC 10 Asbestos-cement
 2 Brass 4 Galvanized steel 6 Concrete tile 8 RMP (SR) 11 Other (specify)
 12 None used (open hole)

SCREEN OR PERFORATION OPENINGS ARE:
 1 Continuous slot 3 Mill slot 5 Gauzed wrapped 8 Saw cut 11 None (open hole)
 2 Louvered shutter 4 Key punched 6 Wire wrapped 9 Drilled holes
 7 Torch cut 10 Other (specify)

SCREEN-PERFORATED INTERVALS: From 23 ft. to 38 ft., From ft. to ft.
 From ft. to ft., From ft. to ft.
 GRAVEL PACK INTERVALS: From 22 ft. to 48 ft., From ft. to ft.
 From ft. to ft., From ft. to ft.

6 GROUT MATERIAL: 1 Neat cement 2 Cement grout 3 Bentonite 4 Other: hole plug
 Grout Intervals: From 0 ft. to 22 ft., From ft. to ft., From ft. to ft.

What is the nearest source of possible contamination:
 1 Septic tank 4 Lateral lines 7 Pit privy 10 Livestock pens 14 Abandoned water well
 2 Sewer lines 5 Cess pool 8 Sewage lagoon 11 Fuel storage 15 Oil well/Gas well
 3 Watertight sewer lines 6 Seepage pit 9 Feedyard 12 Fertilizer storage 16 Other (specify below)
 13 Insecticide storage
 Direction from well? NE How many feet? 160'

FROM	TO	LITHOLOGIC LOG	FROM	TO	PLUGGING INTERVALS
0	6	Top Soil			
6	11	Clay-Brown			
11	25	Fine Sand-Brown			
25	27	Clay-Brown			
27	36	Fine Sand-Brown			
36	38	Clay-Brown			
38	58	Clay-Blue			
58	60	Gravel-Blue-Grey			

7 CONTRACTOR'S OR LANDOWNER'S CERTIFICATION: This water well was (1) constructed, (2) reconstructed, or (3) plugged under my jurisdiction and was completed on (mo/day/year) 8-06-90 and this record is true to the best of my knowledge and belief. Kansas Water Well Contractor's License No. 182 This Water Well Record was completed on (mo/day/yr) 9-11-90 under the business name of STRADER DRILLING CO., INC. by (signature) *Dale Strader*