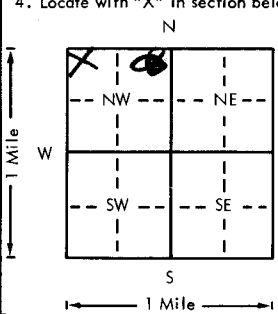
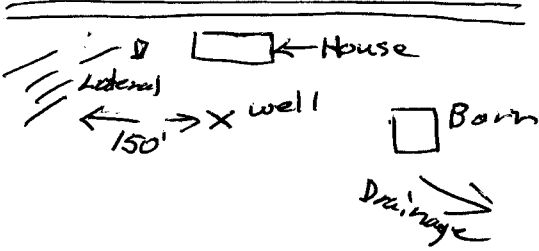


USE TYPEWRITER OR BALL POINT PEN-PRESS FIRMLY, PRINT CLEARLY.

WATER WELL RECORD  
KSA 82a-1201-1215

Kansas Department of Health and Environment-Division of Environment  
(Water well Contractors)  
Topeka, Kansas 66620

1. Location of well: County <b>JACKSON</b>		Fraction <b>NW NW</b> <del>NE</del> 1/4 <del>SE</del> 1/4 NW 1/4	Section number <b>35</b>	Township number <b>T 6 S R 15 E</b>	Range number <b>15 E</b>
2. Distance and direction from nearest town or city: <b>1 N + 1 3/4 E</b> Street address of well location if in city: <b>Holtan, Ks.</b>			3. Owner of well: <b>Marion Noble</b> R.R. or street: <b>RR</b> City, state, zip code: <b>Holtan, Kansas</b>		
4. Locate with "X" in section below: 		Sketch map: 		6. Bore hole dia. <b>10</b> in. Completion date <b>4-8-77</b> Well depth <b>135</b> ft.	
5. Type and color of material		From	To	7. <input type="checkbox"/> Cable tool <input checked="" type="checkbox"/> Rotary <input type="checkbox"/> Driven <input type="checkbox"/> Dug <input type="checkbox"/> Hollow rod <input type="checkbox"/> Jetted <input type="checkbox"/> Bored <input type="checkbox"/> Reverse rotary	
				8. Use: <input checked="" type="checkbox"/> Domestic <input type="checkbox"/> Public supply <input type="checkbox"/> Industry <input type="checkbox"/> Irrigation <input type="checkbox"/> Air conditioning <input type="checkbox"/> Stock <input type="checkbox"/> Lawn <input type="checkbox"/> Oil field water <input type="checkbox"/> Other	
				9. Casing: Material <b>PVC</b> Height: Above or below Threaded <input type="checkbox"/> Welded <input type="checkbox"/> Surface <b>24</b> in. RMP <input type="checkbox"/> PVC Cement Weight <b>2.74</b> lbs./ft. Dia. <b>5</b> in. to <b>135</b> ft. depth Wall Thickness: inches or Dia. <input type="checkbox"/> in. to <input type="checkbox"/> ft. depth gage No. <b>258</b>	
				10. Screen: Manufacturer's name <b>Pumped</b> Type <b>PVC</b> Dia. <b>5"</b> MHC Slot/gauze <b>030</b> Length <b>20'</b> Set between <b>115</b> ft. and <b>135</b> ft. ft. and <input type="checkbox"/> ft. Gravel pack? <input type="checkbox"/> Size range of material <b>030-060</b>	
				11. Static water level: <input type="checkbox"/> mo./day/yr. <b>50</b> ft. below land surface Date <b>4-8-77</b>	
				12. Pumping level below land surfaces: <b>Dir Test</b> <input type="checkbox"/> ft. after <input type="checkbox"/> hrs. pumping <input type="checkbox"/> g.p.m. <input type="checkbox"/> ft. after <input type="checkbox"/> hrs. pumping <input type="checkbox"/> g.p.m. Estimated maximum yield <b>15</b> g.p.m.	
				13. Water sample submitted: <input type="checkbox"/> mo./day/yr. <input type="checkbox"/> Yes <input checked="" type="checkbox"/> No Date <input type="checkbox"/>	
				14. Well head completion: <b>Top Coped</b> <input type="checkbox"/> Pitless adapter <input type="checkbox"/> Inches above grade	
				15. Well grouted? <b>yes</b> With: <input checked="" type="checkbox"/> Neat cement <input type="checkbox"/> Bentonite <input type="checkbox"/> Concrete Depth: From <b>5</b> ft. to <b>15</b> ft.	
				16. Nearest source of possible contamination: ft. <b>150</b> Direction <b>NW</b> Type <b>Lateral</b> Well disinfected upon completion? <input type="checkbox"/> Yes <input checked="" type="checkbox"/> No	
				17. Pump: <input checked="" type="checkbox"/> Not installed Manufacturer's name <input type="checkbox"/> Model number <input type="checkbox"/> HP <input type="checkbox"/> Volts <input type="checkbox"/> Length of drop pipe <input type="checkbox"/> ft. capacity <input type="checkbox"/> g.p.m. Type: <input type="checkbox"/> Submersible <input type="checkbox"/> Turbine <input type="checkbox"/> Jet <input type="checkbox"/> Reciprocating <input type="checkbox"/> Centrifugal <input type="checkbox"/> Other	
(Use a second sheet if needed)					
18. Elevation: <b>1113</b> Topography: <input type="checkbox"/> Hill <input checked="" type="checkbox"/> Slope <input type="checkbox"/> Upland <input type="checkbox"/> Valley		19. Remarks: <b>owner will pour cement slab around well</b>		20. Water well contractor's certification: This well was drilled under my jurisdiction and this report is true to the best of my knowledge and belief. <b>STRADER DRILL CO INC 182</b> Business name License No. Address <b>RT1 Holtan, Ks</b> Signed <b>Dale Arkes</b> Date <b>4-12-77</b> Authorized representative	

Forward the white, blue and pink copies to the Department of Health and Environment

Form WWC-5