


1 LOCATION OF WATER WELL: County: **Jackson** Fraction: **NE 1/4 SE 1/4 SE 1/4** Section Number: **16** Township Number: **T 6 S** Range Number: **R 15** **15**

Distance and direction from nearest town or city street address of well if located within city?

2 WATER WELL OWNER: **U.S. Army corp of Engineers** RR#, St. Address, Box #: **p.o. box 59 Louisville Ky. 40201** Board of Agriculture, Division of Water Resources City, State, ZIP Code:  **Louisville Ky. 40201** Application Number:

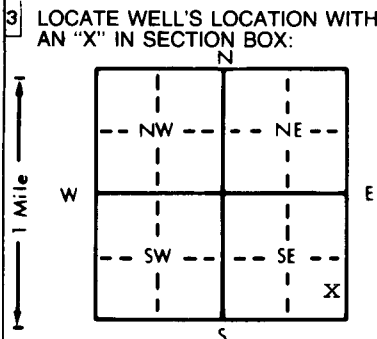

4 DEPTH OF COMPLETED WELL: **60** ft. ELEVATION: Depth(s) Groundwater Encountered: **1.49** ft. 2. ft. 3. ft. WELL'S STATIC WATER LEVEL: **38.17** ft. below land surface measured on **mo/day/yr 4-03-02** Pump test data: Well water was **n/a** ft. after hours pumping gpm Est. Yield gpm: Well water was ft. after hours pumping gpm Bore Hole Diameter: **8** in. to ft., and in. to ft. WELL WATER TO BE USED AS: 5 Public water supply 8 Air conditioning 11 Injection well 1 Domestic 3 Feedlot 6 Oil field water supply 9 Dewatering 12 Other (Specify below) 2 Irrigation 4 Industrial 7 Lawn and garden only 10 Monitoring well Was a chemical/bacteriological sample submitted to Department? Yes No **X**; If yes, mo/day/yr sample was submitted Water Well Disinfected? Yes No **X**

5 TYPE OF BLANK CASING USED: 1 Steel 2 PVC 3 RMP (SR) 4 ABS 5 Wrought iron 6 Asbestos-Cement 7 Fiberglass 8 Concrete tile 9 Other (specify below) CASING JOINTS: Glued Clamped Welded Threaded **X** Blank casing diameter: **2** in. to ft., Dia in. to ft., Dia in. to ft. Casing height above land surface: in., weight lbs./ft. Wall thickness or gauge No. **40** TYPE OF SCREEN OR PERFORATION MATERIAL: 1 Steel 2 Brass 3 Stainless steel 4 Galvanized steel 5 Fiberglass 6 Concrete tile 7 PVC 8 RMP (SR) 9 ABS 10 Asbestos-cement 11 Other (specify) 12 None used (open hole) SCREEN OR PERFORATION OPENINGS ARE: 1 Continuous slot 2 Louvered shutter 3 Mill slot 4 Key punched 5 Gauzed wrapped 6 Wire wrapped 7 Torch cut 8 Saw cut 9 Drilled holes 10 Other (specify) 11 None (open hole) SCREEN-PERFORATED INTERVALS: From **60** ft. to **50** ft., From ft. to ft. From ft. to ft. From ft. to ft. GRAVEL PACK INTERVALS: From **60** ft. to **48** ft., From ft. to ft. From ft. to ft. From ft. to ft.

6 GROUT MATERIAL: 1 Neat cement 2 Cement grout 3 Bentonite 4 Other cement/bentonite Grout Intervals: From **48** ft. to **3** ft., From ft. to ft. From ft. to ft. From ft. to ft. What is the nearest source of possible contamination: 1 Septic tank 2 Sewer lines 3 Watertight sewer lines 4 Lateral lines 5 Cess pool 6 Seepage pit 7 Pit privy 8 Sewage lagoon 9 Feedyard 10 Livestock pens 11 Fuel storage 12 Fertilizer storage 13 Insecticide storage 14 Abandoned water well 15 Oil well/Gas well 16 Other (specify below) Direction from well? How many feet?

FROM	TO	LITHOLOGIC LOG	FROM	TO	PLUGGING INTERVALS
0	10	stiff silty clay/gravel			
10	20	yellowish brown clay			
20	30	hard silty clay			
30	40	olive, hard silty clay			
40	50	moist, fine to medium sand			
50	60	dark gray fine to med. sand			


7 CONTRACTOR'S OR LANDOWNER'S CERTIFICATION: This water well was (1) constructed, (2) reconstructed, or (3) plugged under my jurisdiction and was completed on (mo/day/year) **4-02-02** and this record is true to the best of my knowledge and belief. Kansas Water Well Contractor's License No. **597** This Water Well Record was completed on (mo/day/yr) **4-19-02** under the business name of **prosonic corporation** by (signature) *[Signature]*

INSTRUCTIONS: Use typewriter or ball point pen. PLEASE PRESS FIRMLY and PRINT clearly. Please fill in blanks, underline or circle the correct answers. Send top three copies to Kansas Department of Health and Environment, Bureau of Water, Topeka, Kansas 66620-0001. Telephone: 913-296-5545. Send one to WATER WELL OWNER and retain one for your records.

### HTW DRILLING LOG

Hole No. **MW-911**

1. Company Name <b>Ellis Environmental Group, LC</b>		2. Drilling Subcontractor <b>Prasonic</b>		Sheet 1 of Sheets 8				
3. Project <b>Forbes Atlas S-9</b>			4. Location <b>Holton, Kansas</b>					
5. Name of Driller <b>Bear</b>			6. Manufacturers Designation of Drill <b>Hawk 70-150</b>					
7. Sizes and Types of Drilling and Sampling Equipment <b>Sonic Sonic 8 inch outer core, 6 inch inner core barrel 6 inch stainless steel core barrel</b>			8. Hole Location <b>MW-911</b>					
			9. Surface Elevation <b>10000</b>					
12. Overburdened Thickness <b>undetermined</b>			15. Depth Ground Water Encountered <b>49 ft/bgs, 4-2-02</b>					
13. Depth Drilled into Rock <b>0</b>			16. Depth to Water and Elapsed Time after Drilling Completed <b>38.17 ft, 4-3-02 @ 0755</b>					
14. Total Depth of Hole <b>60ft</b>			17. Over Water Level Measurements (Specify)					
18. Geotechnical Samples <b>MW-911-61, 15-16 ft, 4-2-02 @1520</b>		Disturbed <b>0</b>	Undisturbed <b>0</b>	19. Total Number of Core Boxes <b>0</b>				
20. Samples for Chemical Analysis		VOC	Metals	Other (Specify)	Other (Specify)			
<b>MWS-911-01, 02, 03, 04, 05</b>		<b>5</b>	<b>0</b>	<b>4</b>	<b>2, (1) replicate</b>			
22. Disposition of Hole		Backfilled	Monitoring Well	Other (Specify)	23. Signature of Inspector			
Converted to monitoring well		NO	MW-911	Forbes Atlas S-9				
Elev a	Depth b	Lith	Descriptions of Materials c	Field Screening Results d	Geo-Tech Sample or Core Box No. e	Analytical Sample No. f	Pocket Penetrometer g	Remarks h

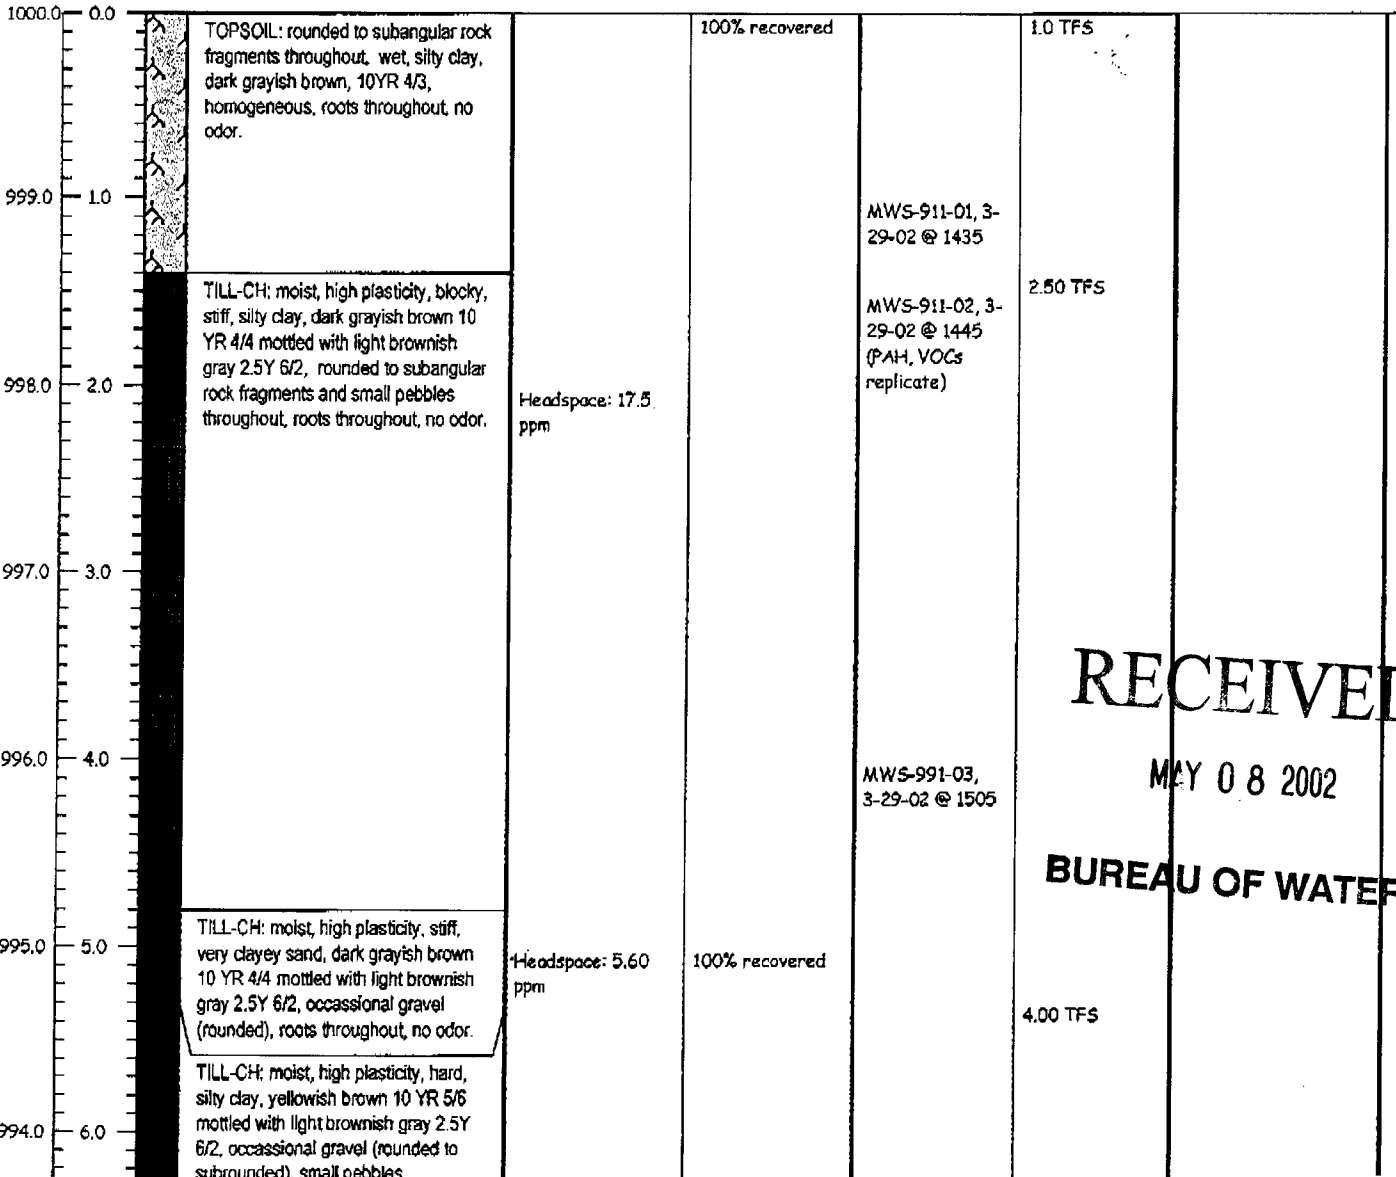

Project **Forbes Atlas S-9**

Hole No. **MW-911**

# HTW DRILLING LOG

Hole No.  
MW-911

1. Project <b>Forbes Atlas S-9</b>			2. Inspector <b>Jeffrey Finn</b>			Sheet 2 of Sheets 8	
Elev a	Depth b	Descriptions of Materials c	Field Screening Results d	Geo-Tech Sample or Core Box No. e	Analytical Sample No. f	Pocket Penetrometer g	Remarks h

993.0	7.0	subrounded), small pebbles throughout, occasional calcareous nodules, traces of iron oxide, roots throughout, no odor.					
992.0	8.0	TILL-CH: becomes pale olive 5Y 6/4, silty clay, with slickensides.					
991.0	9.0						
990.0	10.0	TILL-CH: becomes light yellowish brown silty clay 2.5Y 6/2, vertical sand stringers.	Headspace: 5.20 ppm			3.50 TFS	
989.0	11.0	TILL-CL: SAA increasing sand content, coarse sand.					
988.0	12.0	TILL-CL: SAA, Iron oxide staining from 12 to 14.8 ft, occasional weathered rock from 14 to 14.8 ft					
987.0	13.0						
986.0	14.0						
985.0	15.0	TILL-CH: dry to moist, high plasticity, very stiff, silty clay, yellowish brown 10	Headspace: 3.10	100% recovered,		2.50 TFS	

**HTW DRILLING LOG**

Hole No. MW-911

1. Project Forbes Atlas S-9

2. Inspector Jeffrey Finn

Sheet 3 of Sheets 8

Elev a	Depth b	Descriptions of Materials c	Field Screening Results d	Geo-Tech Sample or Core Box No. e	Analytical Sample No. f	Pocket Penetrometer g	Remarks h
-----------	------------	--------------------------------	------------------------------	--------------------------------------	----------------------------	--------------------------	--------------

984.0	16.0	YR 5/6 mottled with light brownish gray 2.5Y 6/2, occasional small, rounded pebbles, no odor.	ppm	collected MW-911-61, 4-2-02 @1520.		3.50 TFS	
983.0	17.0						
982.0	18.0		Headspace: 7.50 ppm			4.25 TFS	
981.0	19.0						
980.0	20.0	TILL-CH: moist, high plasticity, hard, silty clay, yellowish brown 10 YR 5/8 mottled with light brownish gray 2.5Y 6/2, Traces of dark gray 10YR 4/1 clay, small rounded pebbles scattered throughout, occasional small rounded gravel, no odor.					
979.0	21.0						
978.0	22.0						
977.0	23.0					4.50 TFS	
976.0	24.0						

# HTW DRILLING LOG

Hole No. MW-911

1. Project Forbes Atlas S-9			2. Inspector Jeffrey Finn			Sheet 4 of Sheets 8	
Elev a	Depth b	Descriptions of Materials c	Field Screening Results d	Geo-Tech Sample or Core Box No. e	Analytical Sample No. f	Pocket Penetrometer g	Remarks h

975.0	25.0		Headspace: 3.00 ppm	100% recovered, commenced drilling to allow water to seep into hole, dry hole at this point.	MWS-911-04, 3-29-02 @ 1710  MWS-911-05, 3-29-02 @ 1720, (TOC replicate)	3.50 TFS	
974.0	26.0						
973.0	27.0						
972.0	28.0	TILL-CH: dry to moist, high plasticity, hard, silty clay, olive S Y 4/4 mottled with very dark gray S Y 3/1, small rounded pebbles scattered throughout, no odor.	Headspace: 3.40 ppm			>4.50 TFS	
971.0	29.0						
970.0	30.0						
969.0	31.0		Headspace: 0.00 ppm				
968.0	32.0						

### HTW DRILLING LOG

Hole No. MW-911

1. Project Forbes Atlas S-9			2. Inspector Jeffrey Finn			Sheet 5 of Sheets 8	
Elev a	Depth b	Descriptions of Materials c	Field Screening Results d	Geo-Tech Sample or Core Box No. e	Analytical Sample No. f	Pocket Penetrometer g	Remarks h

967.0	33.0						
966.0	34.0						
965.0	35.0	TILL-SP: moist, fine to medium grain sand, dark gray 10 YR 4/1, sand lense, no odor.				1.00 TFS	
964.0	36.0	TILL-CL: dry to moist, med. plasticity, hard, silty clay, dark gray 10 YR 4/1, small rounded pebbles scattered throughout, no odor.		4-2-02 resumed drilling after resetting drill rig on hole, lower clay layers swelled shut, driller advanced to 35 ft/bgs		>4.50 TFS	
963.0	37.0	TILL-SM: moist, fine to medium grain sand, dark gray 10 YR 4/1, silty sand, no odor.					
962.0	38.0	TILL-CH: dry to moist, high plasticity, hard, silty clay, dark gray 10 YR 4/1, no odor.					
961.0	39.0	TILL-SP: moist, fine to medium grain sand, dark gray 10 YR 4/1, sand lense, no odor.					
960.0	40.0	TILL-SM: moist to wet, fine to medium grain sand, soft to medium, dark gray 10 YR 4/1, sandy silty, no odor.				1.00 TFS	
959.0	41.0	TILL-CH: dry to moist, high plasticity, hard, overconsolidated, silty clay, dark gray 10 YR 4/1, no odor.				>4.50 TFS	

### HTW DRILLING LOG

Hole No.  
MW-911

1. Project Forbes Atlas S-9

2. Inspector Jeffrey Finn

Sheet 6  
of Sheets 8

Elev a	Depth b	Descriptions of Materials c	Field Screening Results d	Geo-Tech Sample or Core Box No. e	Analytical Sample No. f	Pocket Penetrometer g	Remarks h
-----------	------------	--------------------------------	---------------------------------	---	-------------------------------	-----------------------------	--------------

958.0	42.0						
957.0	43.0	TILL-SM: wet, fine to medium grain sand, medium, dark gray 10 YR 4/1, sandy silty, rapid dilatancy, no odor.				1.00 TFS	
956.0	44.0	TILL-CH: dry to moist, high plasticity, hard, overconsolidated, silty clay, dark gray 10 YR 4/1, small, rounded pebbles throughout, no odor.				>4.50 TFS	
955.0	45.0		Headspace: 0.00 ppm	100% recovered			
954.0	46.0						
953.0	47.0						
952.0	48.0						
951.0	49.0					0.50 TFS	groundwater was first encountered at approximately 49 ft/bgs
950.0	50.0	TILL-SP: wet, fine to medium grain sand, gray 10 YR 5/1, basal sand, rounded to subrounded gravel from 59 to 60 f, no odor.	Headspace: 0.00 ppm	100% recovered			

### HTW DRILLING LOG


Hole No. MW-911

1. Project Forbes Atlas S-9

2. Inspector Jeffrey Finn


Sheet 7 of Sheets 8

Elev a	Depth b	Descriptions of Materials c	Field Screening Results d	Geo-Tech Sample or Core Box No. e	Analytical Sample No. f	Pocket Penetrometer g	Remarks h
-----------	------------	--------------------------------	------------------------------	--------------------------------------	----------------------------	--------------------------	--------------

<div style="display: flex; flex-direction: column; align-items: center;"> <div style="margin-bottom: 10px;">949.0</div> <div style="margin-bottom: 10px;">948.0</div> <div style="margin-bottom: 10px;">947.0</div> <div style="margin-bottom: 10px;">946.0</div> <div style="margin-bottom: 10px;">945.0</div> <div style="margin-bottom: 10px;">944.0</div> <div style="margin-bottom: 10px;">943.0</div> <div style="margin-bottom: 10px;">942.0</div> <div style="margin-bottom: 10px;">941.0</div> </div>	<div style="display: flex; flex-direction: column; align-items: center;"> <div style="margin-bottom: 10px;">51.0</div> <div style="margin-bottom: 10px;">52.0</div> <div style="margin-bottom: 10px;">53.0</div> <div style="margin-bottom: 10px;">54.0</div> <div style="margin-bottom: 10px;">55.0</div> <div style="margin-bottom: 10px;">56.0</div> <div style="margin-bottom: 10px;">57.0</div> <div style="margin-bottom: 10px;">58.0</div> <div style="margin-bottom: 10px;">59.0</div> </div>		<p>Headspace: 0.00 ppm</p>	<p>100% recovered</p>	<p>1.0 TFS</p>	<p>well set @ 60 ft/bgs, 3.34 ft. of riser</p>
--	---	--	----------------------------	-----------------------	----------------	--

TILL-GP: wet, Gravel with fine to medium grain sand, gray 10 YR 5/1, rounded to subrounded, large limestone rock fragments, no odor.

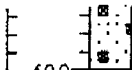

HTW DRILLING LOG						Hole No. MW-911	
1. Project Forbes Atlas S-9			2. Inspector Jeffrey Finn			Sheet 8 of Sheets 8	
Elev a	Depth b	Descriptions of Materials c	Field Screening Results d	Geo-Tech Sample or Core Box No. e	Analytical Sample No. f	Pocket Penetrometer g	Remarks h
940.0	60.0						-