


1 LOCATION OF WATER WELL: County: Jackson Fraction: se 1/4 ne 1/4 se 1/4 Section Number: 16 Township Number: T 6 S Range Number: R 15 EW

Distance and direction from nearest town or city street address of well if located within city?

2 WATER WELL OWNER: U.S. Army Corp of Engineers  
 RR#, St. Address, Box #: P.O. Box 59 Louisville Ky. 40201 Board of Agriculture, Division of Water Resources  
 City, State, ZIP Code: \_\_\_\_\_ Application Number: \_\_\_\_\_

3 LOCATE WELL'S LOCATION WITH AN "X" IN SECTION BOX:

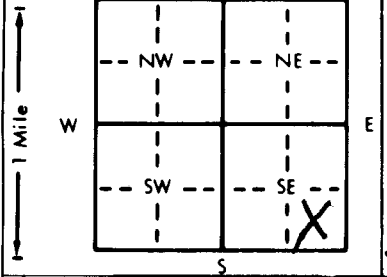

4 DEPTH OF COMPLETED WELL: 25 ft. ELEVATION: \_\_\_\_\_  
 Depth(s) Groundwater Encountered: 1. 13 ft. 2. \_\_\_\_\_ ft. 3. \_\_\_\_\_ ft.  
 WELL'S STATIC WATER LEVEL: 17.31 ft. below land surface measured on mo/day/yr 4-03-02  
 Pump test data: Well water was n/a ft. after \_\_\_\_\_ hours pumping \_\_\_\_\_ gpm  
 Est. Yield \_\_\_\_\_ gpm: Well water was \_\_\_\_\_ ft. after \_\_\_\_\_ hours pumping \_\_\_\_\_ gpm  
 Bore Hole Diameter: 8 in. to \_\_\_\_\_ ft., and \_\_\_\_\_ in. to \_\_\_\_\_ ft.  
 WELL WATER TO BE USED AS:  
 5 Public water supply 8 Air conditioning 11 Injection well  
 1 Domestic 3 Feedlot 6 Oil field water supply 9 Dewatering 12 Other (Specify below)  
 2 Irrigation 4 Industrial 7 Lawn and garden only 10 Monitoring well  
 Was a chemical/bacteriological sample submitted to Department? Yes \_\_\_\_\_ No x \_\_\_\_\_; If yes, mo/day/yr sample was submitted \_\_\_\_\_  
 Water Well Disinfected? Yes \_\_\_\_\_ No x \_\_\_\_\_

5 TYPE OF BLANK CASING USED:  
 1 Steel 3 RMP (SR) 5 Wrought iron 8 Concrete tile CASING JOINTS: Glued \_\_\_\_\_ Clamped \_\_\_\_\_  
 2 PVC 4 ABS 6 Asbestos-Cement 9 Other (specify below) Welded \_\_\_\_\_  
 7 Fiberglass \_\_\_\_\_ Threaded \_\_\_\_\_

Blank casing diameter: 2 in. to \_\_\_\_\_ ft., Dia \_\_\_\_\_ in. to \_\_\_\_\_ ft., Dia \_\_\_\_\_ in. to \_\_\_\_\_ ft.  
 Casing height above land surface: \_\_\_\_\_ in., weight \_\_\_\_\_ lbs./ft. Wall thickness or gauge No. sch. 40

TYPE OF SCREEN OR PERFORATION MATERIAL:  
 1 Steel 3 Stainless steel 5 Fiberglass 7 PVC 10 Asbestos-cement  
 2 Brass 4 Galvanized steel 6 Concrete tile 8 RMP (SR) 11 Other (specify) \_\_\_\_\_  
 9 ABS 12 None used (open hole)

SCREEN OR PERFORATION OPENINGS ARE:  
 1 Continuous slot 3 Mill slot 5 Gauzed wrapped 8 Saw cut 11 None (open hole)  
 2 Louvered shutter 4 Key punched 6 Wire wrapped 9 Drilled holes  
 7 Torch cut 10 Other (specify) \_\_\_\_\_

SCREEN-PERFORATED INTERVALS: From 25 ft. to 15 ft., From \_\_\_\_\_ ft. to \_\_\_\_\_ ft.  
 From \_\_\_\_\_ ft. to \_\_\_\_\_ ft., From \_\_\_\_\_ ft. to \_\_\_\_\_ ft.  
 GRAVEL PACK INTERVALS: From 25 ft. to 13 ft., From \_\_\_\_\_ ft. to \_\_\_\_\_ ft.  
 From \_\_\_\_\_ ft. to \_\_\_\_\_ ft., From \_\_\_\_\_ ft. to \_\_\_\_\_ ft.

6 GROUT MATERIAL: 1 Neat cement 2 Cement grout 3 Bentonite 4 Other cement/bentonite  
 Grout Intervals: From 11 ft. to 3 ft., From \_\_\_\_\_ ft. to \_\_\_\_\_ ft., From \_\_\_\_\_ ft. to \_\_\_\_\_ ft.

What is the nearest source of possible contamination:  
 1 Septic tank 4 Lateral lines 7 Pit privy 10 Livestock pens 14 Abandoned water well  
 2 Sewer lines 5 Cess pool 8 Sewage lagoon 11 Fuel storage 15 Oil well/Gas well  
 3 Watertight sewer lines 6 Seepage pit 9 Feedyard 12 Fertilizer storage 16 Other (specify below)  
 13 Insecticide storage \_\_\_\_\_

Direction from well? \_\_\_\_\_ How many feet? \_\_\_\_\_

FROM	TO	LITHOLOGIC LOG	FROM	TO	PLUGGING INTERVALS
10	20	topsoil, till			
20	25	till			

7 CONTRACTOR'S OR LANDOWNER'S CERTIFICATION: This water well was (1) constructed, (2) reconstructed, or (3) plugged under my jurisdiction and was completed on (mo/day/year) 3-30-02 and this record is true to the best of my knowledge and belief. Kansas Water Well Contractor's License No. 597. This Water Well Record was completed on (mo/day/yr) 4-19-02 under the business name of Prosonic Corporation by (signature) \_\_\_\_\_

WATER WELL RECORD

1 LOCATION OF WATER WELL: Fraction NW 1/4 SE 1/4 SE 1/4 Section Number 6 Township Number T 6 S Range Number R 15 E

Country: JACKSON Distance and direction from nearest town or city street address of well if located within city?

2 WATER WELL OWNER: U.S. Army Corps of Engineers Board of Agriculture, Division of Water Resources Application Number: RR#, St. Address, Box #: P.O. Box 59, Louisville, KY 40201 City, State, Zip Code

3 LOCATE WELL'S LOCATION WITH AN "X" IN SECTION BOX: [Diagram showing a 3x3 grid with 'X' in the bottom-right section]

4 DEPTH OF COMPLETED WELL: ft. ELEVATION: ft. Depth(s) Groundwater Encountered: 1. ft. 2. ft. 3. ft. WELL'S STATIC WATER LEVEL: ft. below land surface measured on mo/day/yr Pump test data: Well water was ft. after hours pumping gpm Est. Yield gpm: Well water was ft. after hours pumping gpm Bore Hole Diameter: in. to ft. and in. to ft. WELL WATER TO BE USED AS: 5 Public water supply 8 Air conditioning 11 Injection well 1 Domestic 3 Foodlot 6 Oil field water supply 9 Dewatering 12 Other (Specify below) 2 Irrigation 4 Industrial 7 Lawn and garden only 10 Monitoring well Was a chemical/bacteriological sample submitted to Department? Yes.....No.....; If yes, mo/day/yr sample was submitted Water Well Disinfected? Yes No

5 TYPE OF BLANK CASING USED: 1 Steel 2 PVC 3 RMP (SR) 4 ABS 5 Wrought iron 6 Asbestos-Cement 7 Fiberglass 8 Concrete tile 9 Other (specify below) CASING JOINTS: Glued Clamped Welded Threaded Blank casing diameter in. to ft. Dia in. to ft. Dia lbs./ft. Wall thickness or gauge No. Casing height, above land surface, in., weight TYPE OF SCREEN OR PERFORATION MATERIAL: 1 Steel 2 Brass 3 Stainless steel 4 Galvanized steel 5 Fiberglass 6 Concrete tile 7 PVC 8 RMP (SR) 9 ABS 10 Asbestos-cement 11 Other (specify) 12 None used (open hole) SCREEN OR PERFORATION OPENINGS ARE: 1 Continuous slot 2 Louvered shutter 3 Mill slot 4 Key punched 5 Gauzed wrapped 6 Wire wrapped 7 Torch cut 8 Saw cut 9 Drilled holes 10 Other (specify) 11 None (open hole) SCREEN-PERFORATED INTERVALS: From ft. to ft. From ft. to ft. From ft. to ft. GRAVEL PACK INTERVALS: From ft. to ft. From ft. to ft. From ft. to ft.

6 GROUT MATERIAL: 1 Neat cement 2 Cement grout 3 Bentonite 4 Other From ft. to ft. From ft. to ft. From ft. to ft. What is the nearest source of possible contamination: 1 Septic tank 2 Sewer lines 3 Watertight sewer lines 4 Lateral lines 5 Cess pool 6 Seepage pit 7 Pit privy 8 Sewage lagoon 9 Feedyard 10 Livestock pens 11 Fuel storage 12 Fertilizer storage 13 Insecticide storage 14 Abandoned water well 15 Oil well/Gas well 16 Other (specify below) How many feet?

Direction from well? FROM TO LITHOLOGIC LOG FROM TO PLUGGING INTERVALS


7 CONTRACTOR'S OR LANDOWNER'S CERTIFICATION: This water well was (1) constructed, (2) reconstructed, or (3) plugged under my jurisdiction and completed on (mo/day/year) and this record is true to the best of my knowledge and belief. Kan Water Well Contractor's License No. This Water Well Record was completed on (mo/day/yr) under the business name of by (signature)

INSTRUCTIONS: Use typewriter or ball point pen. PLEASE PRESS FIRMLY and PRINT clearly. Please fill in blanks, underline or circle the correct answers. Send top three copies to Kansas Department of Health and Environment, Bureau of Water, Topeka, Kansas 66620-0001. Telephone: 913-280-6643. Send one to WATER WELL OWNER and retain one for your records.

**HTW DRILLING LOG**

Hole No. MW-913

1. Company Name <b>Ellis Environmental Group, LC</b>		2. Drilling Subcontractor <b>Prosonic</b>		Sheet 1 of Sheets 4	
3. Project <b>Forbes Atlas S-9</b>			4. Location <b>Holton, Kansas</b>		
5. Name of Driller <b>Bear</b>			6. Manufacturers Designation of Drill <b>Hawk 70-150</b>		
7. Sizes and Types of Drilling and Sampling Equipment Sonic Sonic 8 inch outer core, 6 inch inner core barrel 6 inch stainless steel core barrel			8. Hole Location <b>MW-913</b>		11. Date Completed <b>3-30-02</b>
			9. Surface Elevation <b>1005</b>		
12. Overburdened Thickness <b>undetermined</b>			15. Depth Ground Water Encountered <b>13 ft/bgs</b>		
13. Depth Drilled into Rock <b>0</b>			16. Depth to Water and Elapsed Time after Drilling Completed <b>77.31, 4-3-02 @ 0730</b>		
14. Total Depth of Hole <b>25 ft</b>			17. Over Water Level Measurements (Specify)		
18. Geotechnical Samples <b>0</b>		Disturbed <b>0</b>	Undisturbed <b>0</b>	19. Total Number of Core Boxes <b>0</b>	
20. Samples for Chemical Analysis		VOC	Metals	Other (Specify)	Other (Specify)
MWS-913-01,02,03,		<b>3</b>	<b>0</b>		<b>0</b>
22. Disposition of Hole		Backfilled	Monitoring Well	Other (Specify)	23. Signature of Inspector
Converted to monitoring well		NO	MW-913	Forbes Atlas S-9	
Elev a	Depth b	Lith	Descriptions of Materials c	Field Screening Results d	Geo-Tech Sample or Core Box No. e
					Analytical Sample No. f
					Pocket Penetrometer g
					Remarks h

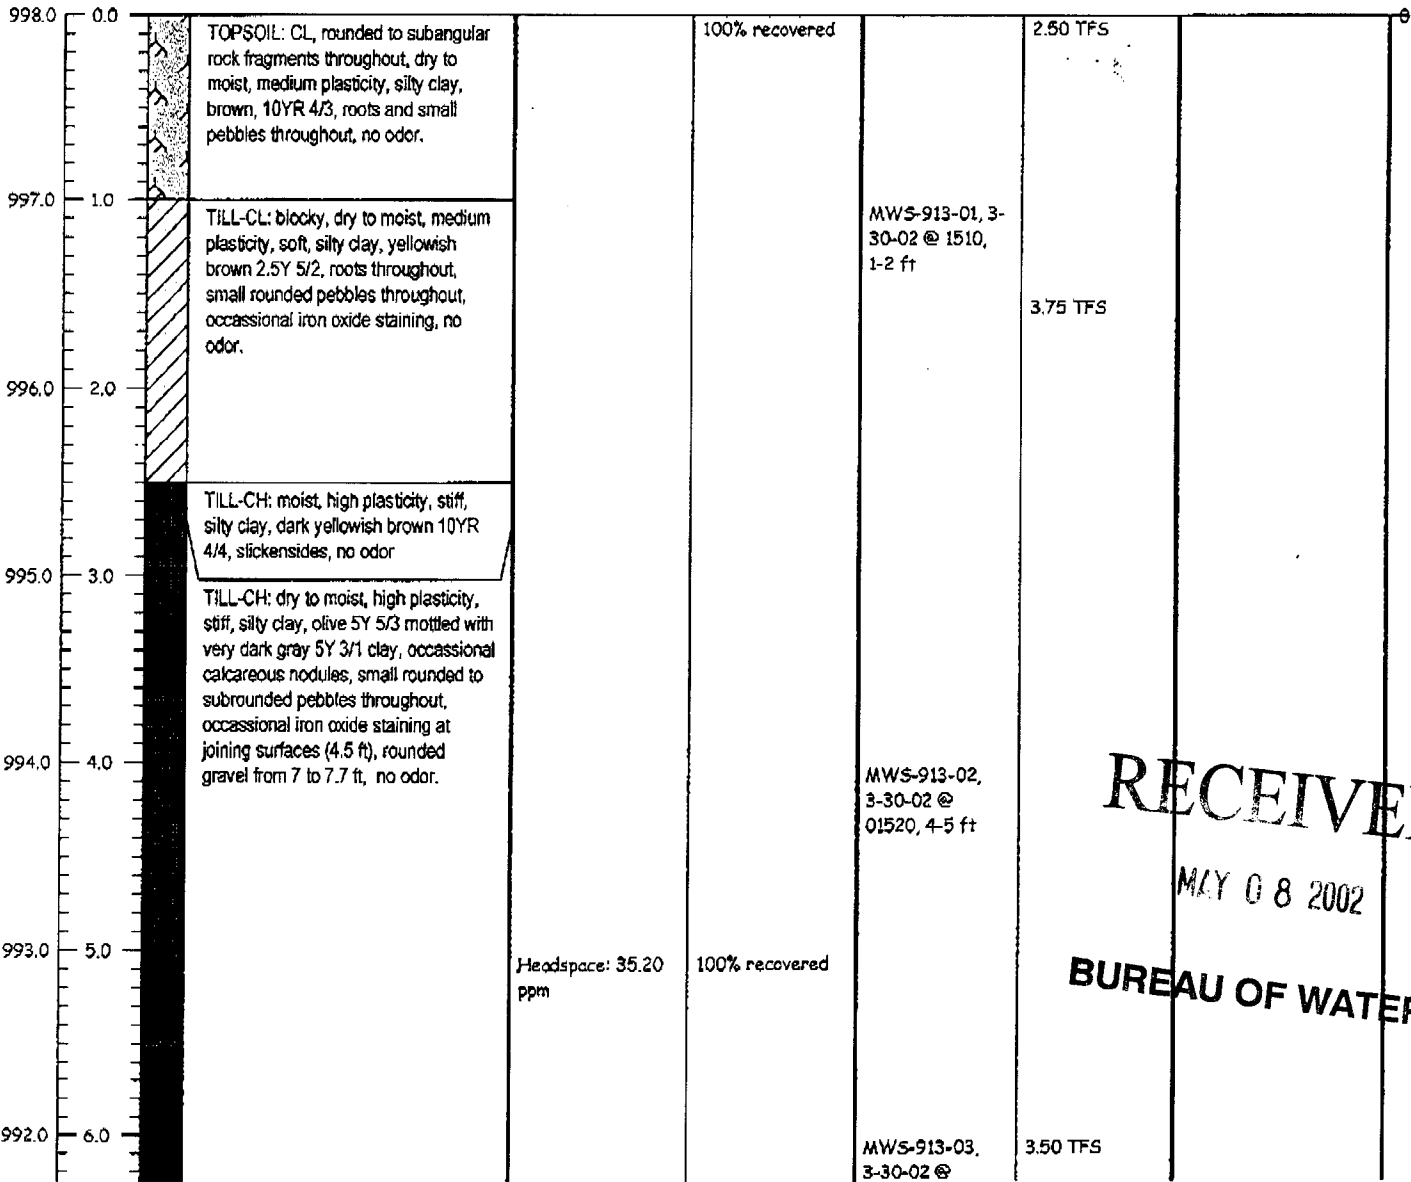

**RECEIVED**

MAY 08 2002

**BUREAU OF WATER**

### HTW DRILLING LOG

Hole No. MW-913

1. Project Forbes Atlas S-9			2. Inspector Jeffrey Finn			Sheet 2 of Sheets 4	
Elev a	Depth b	Descriptions of Materials c	Field Screening Results d	Geo-Tech Sample or Core Box No. e	Analytical Sample No. f	Pocket Penetrometer g	Remarks h

991.0	7.0				3-30-02 @ 1545, 13-14 ft		
990.0	8.0	<p>TILL-SP: sand lense, moist, fine silty sand, olive yellow 2.5Y 6/6, well graded, poorly sorted</p>				0.50 TFS	
989.0	9.0	<p>TILL-CH: moist, high plasticity, silty clay, light olive brown 2.5Y 5/4, small rounded pebbles and gravel throughout, occasional calcareous nodules, black stains in joints. soil becomes slightly sandy and platy from 12 to 12.7 ft.</p>	Headspace: 45.10 ppm			3.50 TFS	
988.0	10.0						
987.0	11.0					3.30 TFS	
986.0	12.0					3.70 TFS	
985.0	13.0	<p>TILL-SP: sand lense, moist to wet, fine silty sand, dark yellowish brown 10YR 4/6, well graded, poorly sorted, iron oxide stained.</p>					groundwater was first encountered at approximately 13 ft/bgs
984.0	14.0	<p>TILL-CH: moist, high plasticity, very stiff, silty clay, yellowish brown 10 YR 5/8 mottled with gray 2.5Y 6/1, weathered rock fragments throughout, no odor.</p>				2.50 TFS	
983.0	15.0	<p>TILL-SP: sand lense, wet, fine silty sand, yellowish brown 10YR 5/6, well graded, poorly sorted.</p>					
		<p>TILL-CH: moist high plasticity, very stiff silty clay yellowish brown 10 YR</p>		100% recovered		3.00 TFS	

# HTW DRILLING LOG

Hole No. MW-913


1. Project Forbes Atlas S-9			2. Inspector Jeffrey Finn			Sheet 3 of Sheets 4	
Elev a	Depth b	Descriptions of Materials c	Field Screening Results d	Geo-Tech Sample or Core Box No. e	Analytical Sample No. f	Pocket Penetrometer g	Remarks h

982.0	16.0	<p>stiff, silty clay, yellowish brown 10 YR 5/6, weathered rock fragments and small pebbles throughout, occasional calcareous nodules, no odor.</p> <p>TILL-SP: sand lense, wet, fine silty sand, yellowish brown 10YR 5/6, well graded, poorly sorted..</p>				2.50 TFS	
980.0	18.0	<p>TILL-CL: moist, dark yellowish brown 10YR 4/6 mottled with light brownish gray 10 YR 6/2, iron oxide staining, small rounded pebbles throughout, occasional calcareous nodules, weathered rock fragments.</p>				4.50 TFS	
979.0	19.0	<p>TILL-CL: sand content increased, low plasticity.</p>				3.75 TFS	
978.0	20.0	<p>TILL-CL: moist, hard, medium plasticity, silty clay, light olive brown 5Y 5/2, iron oxide staining throughout, small rounded pebbles throughout, vertical joints stained reddish black.</p>				4.50 TFS	
977.0	21.0	<p>TILL-CL: moist, very stiff, medium plasticity, silty clay, light olive brown 2.5Y 5/4 with vertical joints filled with gray 2.5Y 5/1 clay, trace a small amount of sandy clay, weathered rocks throughout, also traces of olive yellow 2.5Y 6/8 sandy clay.</p>	Headspace: 0.00 ppm			3.50 TFS	
976.0	22.0						
975.0	23.0	<p>TILL-CL: moist, very stiff, medium plasticity, silty clay, olive 5Y 5/4, mottled with reddish brown 7.5 YR 4/4 and very dark gray 7.5YR 3/1, weathered rock fragments scattered throughout, wet, iron stained joints.</p>				3.75 TFS	well set @ 22.86 ft/bgs, 3.60 ft. of riser
974.0	24.0	<p>TILL-CH: moist, high plasticity, hard.</p>					

## HTW DRILLING LOG

Hole No.  
MW-9131. Project  
Forbes Atlas S-92. Inspector  
Jeffrey FinnSheet 4  
of Sheets 4

Elev a	Depth b	Descriptions of Materials c	Field Screening Results d	Geo-Tech Sample or Core Box No. e	Analytical Sample No. f	Pocket Penetrometer g	Remarks h
-----------	------------	--------------------------------	---------------------------------	---	-------------------------------	-----------------------------	--------------

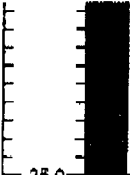

TILL-CH: moist, high plasticity, hard, silty clay, gray 2.5Y 5/1 with a vertical seam of softer grayish brown 2.5Y 5/2, wet clay

Headspace: 0.00  
ppm

&gt;4.50 TFS

973.0

25.0