

1 LOCATION OF WATER WELL: County: <u>JACKSON</u>	Fraction <u>SE 1/4 NE 1/4 SE 1/4</u>	Section Number <u>16</u>	Township Number <u>T 6 S</u>	Range Number <u>R 15 E/W</u>
---	---	-----------------------------	---------------------------------	---------------------------------


Distance and direction from nearest town or city street address of well if located within city?
12719 26th RD., HOLTON, KS

2 WATER WELL OWNER: ARMY CORPS OF ENGINEERS-KANSAS CITY DISTRICT

RR#, St. Address, Box # : 601 E 12TH ST
City, State, ZIP Code : KANSAS CITY, MO 64105

Board of Agriculture, Division of Water Resources
Application Number:

3 LOCATE WELL'S LOCATION WITH AN "X" IN SECTION BOX: 4 DEPTH OF COMPLETED WELL 61.31 ft. ELEVATION:

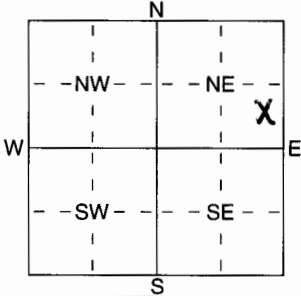

Depth(s) Groundwater Encountered 1 ft. 2 ft. 3 ft.
WELL'S STATIC WATER LEVEL ft. below land surface measured on mo/day/yr
Pump test data: Well water was ft. after hours pumping gpm
Est. Yield gpm: Well water was ft. after hours pumping gpm
WELL WATER TO BE USED AS:
1 Domestic 2 Irrigation 3 Feedlot 4 Industrial 5 Public water supply 6 Oil field water supply 7 Domestic (lawn & garden) 8 Air conditioning 9 Dewatering 10 Monitoring well 11 Injection well 12 Other (Specify below)

Was a chemical/bacteriological sample submitted to Department? Yes No ; If yes, mo/day/yr sample was submitted
Water Well Disinfected? Yes No

5 TYPE OF BLANK CASING USED:
1 Steel 2 PVC 3 RMP (SR) 4 ABS 5 Wrought iron 6 Asbestos-Cement 7 Fiberglass 8 Concrete tile 9 Other (specify below) CASING JOINTS: Glued Clamped Welded Threaded

Blank casing diameter 2 in. to 51.06 ft., Dia in. to ft., Dia in. to ft.
Casing height above land surface in., weight lbs./ft. Wall thickness or gauge No.

TYPE OF SCREEN OR PERFORATION MATERIAL:
1 Steel 2 Brass 3 Stainless Steel 4 Galvanized Steel 5 Fiberglass 6 Concrete tile 7 PVC 8 RMP (SR) 9 ABS 10 Asbestos-Cement 11 Other (Specify) 12 None used (open hole)

SCREEN OR PERFORATION OPENINGS ARE:
1 Continuous slot 2 Louvered shutter 3 Mill slot 4 Key punched 5 Guazed wrapped 6 Wire wrapped 7 Torch cut 8 Saw cut 9 Drilled holes 10 Other (specify) 11 None (open hole)

SCREEN-PERFORATED INTERVALS: From 61.31 ft. to 51.06 ft., From ft. to ft.
GRAVEL PACK INTERVALS: From 61 ft. to 48 ft., From ft. to ft.

6 GROUT MATERIAL: 1 Neat cement 2 Cement grout 3 Bentonite 4 Other
Grout Intervals: From 47 ft. to SURFACE ft., From ft. to ft., From ft. to ft.

What is the nearest source of possible contamination:
1 Septic tank 2 Sewer lines 3 Watertight sewer lines 4 Lateral lines 5 Cess pool 6 Seepage pit 7 Pit privy 8 Sewage lagoon 9 Feedyard 10 Livestock pens 11 Fuel storage 12 Fertilizer storage 13 Insecticide storage 14 Abandoned water well 15 Oil well/Gas well 16 Other (specify below) FORMER ATLAS F MISSILE SILO (ICE)

Direction from well? How many feet? FORMER ATLAS F MISSILE SILO (ICE)

FROM	TO	LITHOLOGIC LOG	FROM	TO	PLUGGING INTERVALS
0	1	DK BRN SILT LOAM			
1	5	FILL			
5	9	YLLW BRN SILTY CLAY W/ GRAVEL			
9	11.5	YLLW BRN F SAND			
11.5	12.5	YLLW BRN SILTY CLAY			
12.5	15	DK GRY BRN SILTY CLAY			
15	45	YLLW BRN SILTY CLAY W/ GRAVEL			
45	45.5	GRY F-M SANDS			
45.5	48.5	DK GRY SILTY CLAY			
48.5	61	YLLW BRN F SANDS			
61	65	DK GRY SILT W/ CLAY			

7 CONTRACTOR'S OR LANDOWNER'S CERTIFICATION: This water well was (1) constructed, (2) reconstructed, or (3) plugged under my jurisdiction and was completed on (mo/day/year) 12 / 03 / 04 and this record is true to the best of my knowledge and belief. Kansas Water Well Contractor's Licence No. 658 This Water Well Record was completed on (mo/day/yr) 01 / 25 / 05 under the business name of BOBBY LONGYEAR by (signature) [Signature]