

County: Jackson Fraction: SW, SW, SW, SW Sec. 11 T. 6 S R. 16 E

**CORRECTION(S) to WATER WELL COMPLETION RECORD Form WWC-5** (to rectify lacking or incorrect information)

Owner: Robert E. Wareham

If location corrected, was listed as:

Section-Township-Range: \_\_\_\_\_

Fraction (1/4 calls): not provided

Location changed to:

SW, SW, SW, SW

Other changes: Initial statements: Hand-dug well reported at owner's address. All plugging materials not reported.

Changed to: Well near NE corner of old house located NE of intersection of X Rd and 270th Rd, about 3 miles S of Whiting, KS. Sand 53-51 ft, sand 50-6 ft, and compacted topsoil 5-0 ft.

Comments: Confirmed well location with landowner. He confirmed plugging materials with contractor. Lat. 39.535391 deg N, Long. -95.606897 deg W (WGS84).

Verification method: Used Google Earth, KDHE STR Finder and info from landowner.

Initials: PKC Date: 8/11/2021

Submitted by: ☐ Kansas Geological Survey, Data Resources Library, 1930 Constant Ave., Lawrence, KS 66047-3724  
☒ Kansas Dept. of Health & Environment, Bureau of Water, 1000 SW Jackson, Suite 420, Topeka, KS 66612-1367

**WATER WELL PLUGGING RECORD Form WWC-5P**
**KSA 82a-1212 ID NO.**

<b>1 LOCATION OF WATER WELL:</b> County: Jackson	Fraction $\frac{1}{4}$ $\frac{1}{4}$ $\frac{1}{4}$ $\frac{1}{4}$	Section Number 11	Township Number 6 T S	Range Number 16 <input checked="" type="checkbox"/> E <input type="checkbox"/> W
---	---	----------------------	--------------------------	---

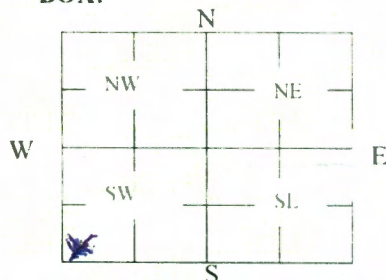
Street/Rural Address of Well Location; if unknown, distance & direction from nearest town or intersection: If at owner's address, check here ☒

**Global Positioning Systems (GPS) information:**

Latitude: \_\_\_\_\_ (in decimal degrees)  
 Longitude: \_\_\_\_\_ (in decimal degrees)  
 Elevation: \_\_\_\_\_  
 Horizontal Datum: ☐ WGS84, ☐ NAD83, ☐ NAD27  
 Collection Method: \_\_\_\_\_

**2 WATER WELL OWNER:** Robert E Wareham  
 RR#, St. Address, Box #: 18099 278th Rd  
 City, State ZIP Code: Whiting, Ks 66552

☐ GPS unit (Make/Model: \_\_\_\_\_)  
☐ Digital Map/Photo, ☐ Topographic Map, ☐ Land Survey  
 Est. Accuracy: ☐ < 3 m. ☐ 3-5 m. ☐ 5-15 m. ☐ > 15 m

**3 MARK WELL'S LOCATION WITH AN "X" IN SECTION BOX:**

**4 DEPTH OF WELL** 53 **ft.**

WELL'S STATIC WATER LEVEL 12 ft

WELL WAS USED AS:

- |  |   |   |
|--|---|---|
| <input checked="" type="checkbox"/> Domestic | <input type="checkbox"/> Public Water Supply      | <input type="checkbox"/> Dewatering     |
| <input type="checkbox"/> Irrigation          | <input type="checkbox"/> Oil Field Water Supply   | <input type="checkbox"/> Monitoring     |
| <input type="checkbox"/> Feedlot             | <input type="checkbox"/> Domestic (Lawn & Garden) | <input type="checkbox"/> Injection Well |
| <input type="checkbox"/> Industrial          | <input type="checkbox"/> Air Conditioning         | <input type="checkbox"/> Other          |

Was a chemical/bacteriological sample submitted to Department? Yes ☐ No ☒

**5 TYPE OF BLANK CASING USED:**

- ☐ Steel ☐ RMP (SR) ☐ Wrought ☐ Fiberglass ☒ Other (Specify below)  
☐ PVC ☐ ABS ☐ Asbestos-Cement ☐ Concrete Tile

Rock Hand Dug

Blank casing diameter 30 in. Was casing pulled? Yes ☒ No ☐ If yes, how much 5'  
 Casing height above or below land surface 0 in.

**6 GROUT PLUG MATERIAL:** ☐ Neat cement ☐ Cement grout ☒ Bentonite ☐ Other \_\_\_\_\_

Grout Plug Intervals: From 5 ft. to 6 ft., From 50 ft. to 51 ft., From \_\_\_\_\_ ft. to \_\_\_\_\_ ft.

What is the nearest source of possible contamination:

- |   |   |   |  |
|---|---|---|--|
| <input type="checkbox"/> Septic tank            | <input type="checkbox"/> Seepage pit    | <input type="checkbox"/> Fuel storage         | <input type="checkbox"/> Other (specify below) |
| <input type="checkbox"/> Sewer lines            | <input type="checkbox"/> Pit privy      | <input type="checkbox"/> Fertilizer storage   | <u>None</u>                                    |
| <input type="checkbox"/> Watertight sewer lines | <input type="checkbox"/> Sewage lagoon  | <input type="checkbox"/> Insecticide storage  |  |
| <input type="checkbox"/> Lateral lines          | <input type="checkbox"/> Feedyard       | <input type="checkbox"/> Abandoned water well | Direction from well? _____                     |
| <input type="checkbox"/> Cess pool              | <input type="checkbox"/> Livestock pens | <input type="checkbox"/> Oil well/Gas well    | How many feet? _____                           |

FROM	TO	PLUGGING MATERIALS	FROM	TO	PLUGGING MATERIALS

**7 CONTRACTOR'S OR LANDOWNER'S CERTIFICATION:** This water well was plugged under my jurisdiction and was completed on (mo/day/year) 6-21-21 and this record is true to the best of my knowledge and belief. Kansas Water Well Contractor's License No. \_\_\_\_\_. This Water Well Record was completed on (mo/day/year) 6-21-21 under the business name of \_\_\_\_\_ by (signature) Robert E. Wareham

Send one white copy to Kansas Department of Health & Environment, Geology Section, 1000 SW Jackson Street, Ste. 420, Topeka, KS 66612-1367. Send one copy to WATER WELL OWNER and retain one for your records.  
 Visit us at <http://www.kdheks.gov/waterwell/index.html> Telephone 785-296-5524.

KSA82a-1212

Revised 1/20/2015

LARDIN