30

USE TYPEWRITER OR BALL POINT PEN-PRESS FIRMLY, PRINT CLEARLY.

WATER WELL RECORD
KSA 82a-1201-1215

Kansas Department of Health and Environment-Division of Environment
(Water well Contractors)
Topeka, Kansas 66620

1. Location of well:	County	Fraction	Section number	Township number	Range number
	Atchison	~~NW~~ NW 1/4 ~~SE~~ 1/4 SW 1/4	27	T 6 S	R 17 (E) W

2. Distance and direction from nearest town or city: 1 E 2.4 N
Street address of well location if in city: of Arrington

3. Owner of well: Jay Armstrong
R.R. or street: R.R.
City, state, zip code: Muscotah, Ks

4. Locate with "X" in section below:

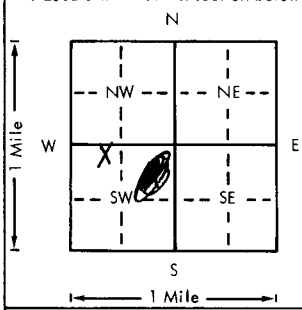

Sketch map:

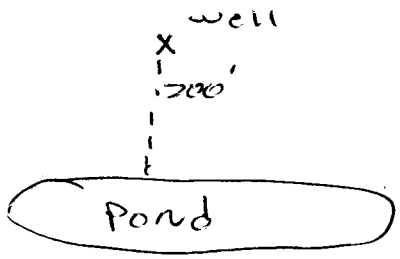

6. Bore hole dia. 12 in. Completion date ____
Well depth 90 ft. 8-22-79

7. __ Cable tool ✓ Rotary __ Driven __ Dug
__ Hollow rod __ Jetted __ Bored __ Reverse rotary

8. Use: ✓ Domestic __ Public supply __ Industry
__ Irrigation __ Air conditioning ✓ Stock
__ Lawn __ Oil field water __ Other

9. Casing: Material PVC Height: (Above) or below
Threaded ____ Welded ____ Surface 24 in.
RMP ____ PVC 91 Weight 2.82 lbs./ft.
Dia. 5 in. to 90 ft. depth Wall Thickness: inches or
Dia. ____ in. to ____ ft. depth gage No. 258

5. Type and color of material	From	To
Top Soil	0	3
Clay, brown	3	38
Fine Sand, water bearing	38	90

(Use a second sheet if needed)

10. Screen: Manufacturer's name Rumpco
Type PVC Dia. 5
(Slot)/gauze .020 Length 10
Set between 77 ft. and 87 ft.
____ ft. and ____ ft.
Gravel pack? ✓ Size range of material .030x.060

11. Static water level: mo./day/yr.
50 ft. below land surface Date 8-22-79

12. Pumping level below land surfaces:
____ ft. after ____ hrs. pumping ____ g.p.m.
____ ft. after ____ hrs. pumping ____ g.p.m.
Estimated maximum yield 100 g.p.m.

13. Water sample submitted: mo./day/yr.
__ Yes ✓ No Date ____

14. Well head completion: Cap
__ Pitless adapter 24 Inches above grade

15. Well grouted? ✓
With: ✓ Neat cement ____ Bentonite ____ Concrete
Depth: From 0 ft. to 10 ft.

16. Nearest source of possible contamination:
ft. 200 Direction S Type Pond
Well disinfected upon completion? ✓ Yes ____ No

17. Pump: ✓ Not installed
Manufacturer's name ____
Model number ____ HP ____ Volts ____
Length of drop pipe ____ ft. capacity ____ g.p.m.
Type:
__ Submersible __ Turbine
__ Jet __ Reciprocating
__ Centrifugal __ Other

T 6 R 17 (E) W Sec 27 1/4 NE 1/4 NE 1/4 SW 1/4

18. Elevation: 990
Topography:
__ Hill
✓ Slope
__ Upland
__ Valley

19. Remarks:
Owner to install slab

20. Water well contractor's certification:
This well was drilled under my jurisdiction and this report is true to the best of my knowledge and belief.
Strader Drlg Co 182
Business name License No.
Address Holton, Ks
Signed Dale Osborn Date 8-23-79
Authorized representative

Forward the white, blue and pink copies to the Department of Health and Environment

Form WWC-5

MI-1023