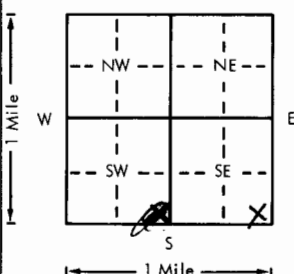
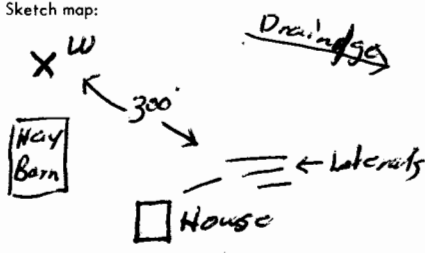


25

USE TYPEWRITER OR BALL
POINT PEN-PRESS FIRMLY,
PRINT CLEARLY.

WATER WELL RECORD
KSA 82a-1201-1215

Kansas Department of Health and
Environment-Division of Environment
(Water well Contractors)
Topeka, Kansas 66620

1. Location of well: County <u>Atchison</u>		Fraction <u>SE</u> <u>SE</u> <u>SW</u> 1/4 1/4 1/4	Section number <u>3025</u>	Township number <u>6</u>	Range number <u>17</u> <u>E</u>
2. Distance and direction from nearest town or city: <u>25 2 1/2 W</u> Street address of well location if in city: <u>Effingham</u>		3. Owner of well: <u>Donald Kleoppper</u> R.R. or street: <u>RR</u> City, state, zip code: <u>Effingham</u>			
4. Locate with "X" in section below: 		Sketch map: 		6. Bore hole dia. <u>10</u> in. Completion date <u>4-12-77</u> Well depth <u>240</u> ft.	
5. Type and color of material		From	To	7. <input checked="" type="checkbox"/> Cable tool <input checked="" type="checkbox"/> Rotary <input type="checkbox"/> Driven <input type="checkbox"/> Dug <input type="checkbox"/> Hollow rod <input type="checkbox"/> Jetted <input type="checkbox"/> Bored <input type="checkbox"/> Reverse rotary	
<u>Loam T.S.</u>		<u>0</u>	<u>2</u>	8. Use: <input checked="" type="checkbox"/> Domestic <input type="checkbox"/> Public supply <input type="checkbox"/> Industry <input type="checkbox"/> Irrigation <input type="checkbox"/> Air conditioning <input type="checkbox"/> Stock <input type="checkbox"/> Lawn <input type="checkbox"/> Oil field water <input type="checkbox"/> Other	
<u>lt. Gray Clay</u>		<u>2</u>	<u>18</u>	9. Casing: Material <u>PVC</u> Height: Above or below Threaded <input type="checkbox"/> Welded <input type="checkbox"/> Surface <u>24</u> in. RMP <input type="checkbox"/> PVC <u>Glue</u> Weight <u>2.74</u> lbs./ft. Dia. <u>5</u> in. to <u>240</u> ft. depth Wall Thickness: inches or Dia. <u>5</u> in. to <u>240</u> ft. depth gage No. <u>258</u>	
<u>White Sandy Clay</u>		<u>18</u>	<u>32</u>	10. Screen: Manufacturer's name <u>Pumco</u> Type <u>PVC</u> Dia. <u>5"</u> Slot/gauze <u>030</u> Length <u>20'</u> Set between <u>220</u> ft. and <u>240</u> ft. Gravel pack? <input checked="" type="checkbox"/> Size range of material <u>080</u>	
<u>yellow clay</u>		<u>32</u>	<u>65</u>	11. Static water level: <u>60</u> ft. below land surface Date <u>4-12-77</u>	
<u>yellow Sandy Clay</u>		<u>65</u>	<u>71</u>	12. Pumping level below land surfaces: <u>Air Test</u> ft. after <u> </u> hrs. pumping <u> </u> g.p.m. ft. after <u> </u> hrs. pumping <u> </u> g.p.m. Estimated maximum yield <u>30</u> g.p.m.	
<u>Blue Clay</u>		<u>71</u>	<u>78</u>	13. Water sample submitted: <u> </u> mo./day/yr. Yes <input checked="" type="checkbox"/> No <input type="checkbox"/> Date <u> </u>	
<u>Brown Silty Clay</u>		<u>78</u>	<u>80</u>	14. Well head completion: <u>Cap Top</u> Pitless adapter <u>24"</u> inches above grade	
<u>Blue Clay</u>		<u>80</u>	<u>126</u>	15. Well grouted? <input checked="" type="checkbox"/> With: <input checked="" type="checkbox"/> Neat cement <input type="checkbox"/> Bentonite <input type="checkbox"/> Concrete Depth: From <u>5</u> ft. to <u>15</u> ft.	
<u>Brown Silty Clay</u>		<u>126</u>	<u>145</u>	16. Nearest source of possible contamination: ft. <u>300</u> Direction <u>SE</u> Type <u>laterals</u> Well disinfected upon completion? <input type="checkbox"/> Yes <input type="checkbox"/> No	
<u>Brown Fine Sand (Flour sand)</u>		<u>145</u>	<u>210</u>	17. Pump: <input checked="" type="checkbox"/> Not installed Manufacturer's name <u> </u> Model number <u> </u> HP <u> </u> Volts <u> </u> Length of drop pipe <u> </u> ft. capacity <u> </u> g.p.m. Type: <input type="checkbox"/> Submersible <input type="checkbox"/> Turbine <input type="checkbox"/> Jet <input type="checkbox"/> Reciprocating <input type="checkbox"/> Centrifugal <input type="checkbox"/> Other	
<u>Brown Med sand</u>		<u>210</u>	<u>231</u>	18. Elevation: <u>1115</u> Topography: <input checked="" type="checkbox"/> Hill <input type="checkbox"/> Slope <input type="checkbox"/> Upland <input type="checkbox"/> Valley	
<u>Gray Shale</u>		<u>231</u>	<u>240</u>	19. Remarks: <u>Owner will construct slab around well</u>	
(Use a second sheet if needed)		20. Water well contractor's certification: This well was drilled under my jurisdiction and this report is true to the best of my knowledge and belief. <u>Strader Dalg Co Inc</u> <u>182</u> Business name License No. Address <u>RT1 Holton, KS</u> Signed <u>Dale Bohren</u> Date <u>4-13-77</u> Authorized representative			

Forward the white, blue and pink copies to the Department of Health and Environment

Form WWC-5