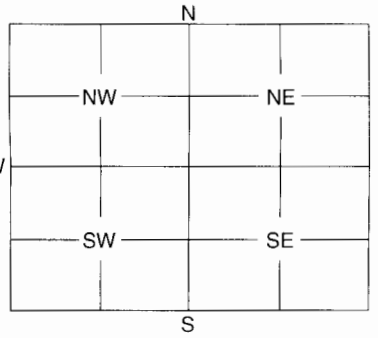


1 LOCATION OF WATER WELL: Fraction Section Number Township Number Range Number
 County: Atchison NW 1/4 NW 1/4 NE 1/4 27 6 17 EW

Distance and direction from nearest town or city street address of well if located within city?
From Muscotah, KS .25 mi East, 3 mi South, 3200' East & 66' South approx.

2 WATER WELL OWNER: Rural Water District No. 5 Atchison County
 RR #, St. Address, Box #: PO Box 65 Board of Agriculture, Division of Water Resources
 City, State, ZIP Code: Lancaster, KS 66041 Application Number: _____

3 MARK WELL'S LOCATION WITH AN "X" IN SECTION BOX:

 4 DEPTH OF WELL 89.5' ft.
 WELL'S STATIC WATER LEVEL 11.5' ft.
 WELL WAS USED AS:
 1 Domestic 5 Public Water Supply 9 Dewatering
 2 Irrigation 6 Oil Field Water Supply 10 Monitoring Well
 3 Feedlot 7 Domestic (Lawn & Garden) 11 Injection Well
 4 Industrial 8 Air Conditioning 12 Other Test Well
 Was a chemical / bacteriological sample submitted to Department? Yes _____ No X
 If yes, mo/day/yr sample was submitted _____
 Water Well Disinfected: Yes X No _____

5 TYPE OF BLANK CASING USED:
 1 Steel 3 RMP (SR) 5 Wrought 7 Fiberglass 9 Other (Specify below)
2 PVC 4 ABS 6 Asbestos-Cement 8 Concrete Tile
 Blank casing diameter 2 in. Was casing pulled? Yes _____ No X If yes, how much _____
 Casing height above or below land surface 36 in.

6 GROUT PLUG MATERIAL: 1 Neat cement 2 Cement grout 3 Bentonite 4 Other _____
 Grout Plug Intervals: From 3 ft. to 89.5 ft., From _____ ft. to _____ ft., From _____ to _____ ft.
 What is the nearest source of possible contamination:
 1 Septic tank 6 Seepage pit 11 Fuel storage 16 Other (specify below)
 2 Sewer lines 7 Pit privy 12 Fertilizer storage
 3 Watertight sewer lines 8 Sewage lagoon 13 Insecticide storage Ditch
 4 Lateral lines 9 Feedyard 14 Abandoned water well
 5 Cess pool 10 Livestock pens 15 Oil well/Gas well
 Direction from well? West How many feet? 150'

FROM	TO	PLUGGING MATERIALS
<u>0</u>	<u>3</u>	<u>Surface Clays</u>
<u>3</u>	<u>89.5</u>	<u>Bentonite</u>

7 CONTRACTOR'S OF LANDOWNER'S CERTIFICATION: This water well was plugged under my jurisdiction and was completed on (mo/day/year) 7-16-2008 and this record is true to the best of my knowledge and belief. Kansas Water Well Contractor's License No. 739 This Water Well Record was completed on (mo/day/year) 7-20-2008 under the business name of Rock Drilling
 by (signature) Mike Rock

INSTRUCTIONS: Use typewriter or ball point pen. Please press firmly and print clearly. Please fill in blanks, underline or circle the correct answers. Send top three copies to Kansas Department of Health and Environment, Bureau of Water, Geology Section, 1000 SW Jackson St., Ste. 420, Topeka, Kansas 66612-1367. Telephone: 785/296-5522. Send one to Water Well Owner and retain one for your records.