


1 LOCATION OF WATER WELL: County: Clay Fraction: NW 1/4 NW 1/4 NE 1/4 Section Number: 23 Township Number: T 6 S Range Number: R 2 EW

Distance and direction from nearest town or city street address of well if located within city? From Clay Center Co 9 miles North on 15 + 2 1/2 miles west on ROCK Rd.

2 WATER WELL OWNER: Greg Cullin
 RR#, St. Address, Box #: 9504 Snowshoe
 City, State, ZIP Code: Helena, MT 59601
 Board of Agriculture, Division of Water Resources
 Application Number:

3 LOCATE WELL'S LOCATION WITH AN "X" IN SECTION BOX:

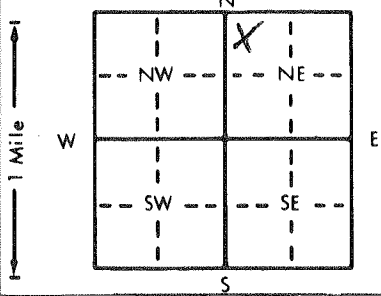

4 DEPTH OF COMPLETED WELL: 80 ft. ELEVATION:

Depth(s) Groundwater Encountered 1. 1 ft. 2. 25 ft. 3. 80 ft.
 WELL'S STATIC WATER LEVEL 25 ft. below land surface measured on mo/day/yr
 Pump test data: Well water was 2 ft. after 9 hours pumping 80 gpm
 Est. Yield 2 gpm: Well water was 2 ft. after 9 hours pumping 80 gpm
 Bore Hole Diameter: 7 in. to 80 ft., and 80 in. to 80 ft.
 WELL WATER TO BE USED AS:
 1 Domestic 3 Feedlot 6 Oil field water supply 9 Dewatering 12 Other (Specify below)
 2 Irrigation 4 Industrial 7 Lawn and garden only 10 Monitoring well
 Was a chemical/bacteriological sample submitted to Department? Yes Yes No No
 If yes, mo/day/yr sample was submitted: Yes No No
 Water Well Disinfected? Yes No No

5 TYPE OF BLANK CASING USED:
 1 Steel 3 RMP (SR) 5 Wrought iron 8 Concrete tile CASING JOINTS: Glued Clamped
 2 PVC 4 ABS 6 Asbestos-Cement 9 Other (specify below) Welded
 7 Fiberglass Threaded

 Casing height above land surface 21 in., weight Sch 40 lbs./ft. Wall thickness or gauge No. 7 PVC

TYPE OF SCREEN OR PERFORATION MATERIAL:
 1 Steel 3 Stainless steel 5 Fiberglass 8 RMP (SR) 11 Other (specify)
 2 Brass 4 Galvanized steel 6 Concrete tile 9 ABS 12 None used (open hole)

SCREEN OR PERFORATION OPENINGS ARE:
 1 Continuous slot 3 Mill slot 5 Gauzed wrapped 8 Saw cut 11 None (open hole)
 2 Louvered shutter 4 Key punched 6 Wire wrapped 9 Drilled holes



What is the nearest source of possible contamination:
 1 Septic tank 4 Lateral lines 7 Pit privy 10 Livestock pens 14 Abandoned water well
 2 Sewer lines 5 Cess pool 8 Sewage lagoon 11 Fuel storage 15 Oil well/Gas well
 3 Watertight sewer lines 6 Seepage pit 9 Feedyard 12 Fertilizer storage 16 Other (specify below)
 13 Insecticide storage

Direction from well? _____ How many feet? _____

FROM	TO	LITHOLOGIC LOG	FROM	TO	PLUGGING INTERVALS
0	1	Top Soil			
1	22	Brown Clay			
22	37	Yellow Shale			
37	37	Limestone			
37	42	Grey Shale			
42	45	Limestone (Water)			
45	53	Grey Shale			
53	56	Limestone			
56	80	Dark Grey Shale			

7 CONTRACTOR'S OR LANDOWNER'S CERTIFICATION: This water well was (1) constructed, (2) reconstructed, or (3) plugged under my jurisdiction and was completed on (mo/day/year) 5/30/95 and this record is true to the best of my knowledge and belief. Kansas Water Well Contractor's License No. 451 This Water Well Record was completed on (mo/day/yr) 5/19/95 under the business name of Holdeman Well Drilling by (signature) Greg Cullin