


1 LOCATION OF WATER WELL:	Fraction	Section Number	Township Number	Range Number
County: <u>Clay</u>	<u>NW 1/4 SE 1/4 NE 1/4</u>	<u>33</u>	<u>6</u>	<u>2 E</u>

Distance and direction from nearest town or city street address of well if located within city?
2 Miles north of Morganville

2 WATER WELL OWNER: <u>Lon V. Silver</u>	Board of Agriculture, Division of Water Resources Application Number: _____
RR #, St. Address, Box #: <u>131 Johnson St.</u>	
City, State, ZIP Code: <u>Morganville KS 67468</u>	

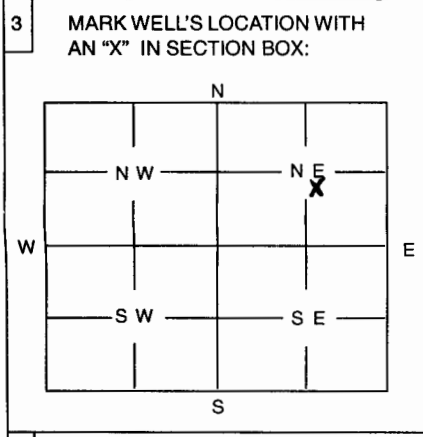

4 DEPTH OF WELL <u>51</u> ft	WELL'S STATIC WATER LEVEL <u>27</u> ft.
WELL WAS USED AS:	
1 Domestic 2 Irrigation 3 Feedlot 4 Industrial	5 Public Water Supply 6 Oil Field Water Supply 7 Domestic (Lawn & Garden) 8 Air Conditioning
9 Dewatering 10 Monitoring Well 11 Injection Well 12 Other	
Was a chemical / bacteriological sample submitted to Department? Yes No <input checked="" type="checkbox"/>	
If yes, mo/day/yr sample was submitted	
Water Well Disinfected: Yes <input checked="" type="checkbox"/> No	

5 TYPE OF BLANK CASING USED:

<input checked="" type="radio"/> Steel	3 RMP (SR)	5 Wrought	7 Fiberglass	9 Other (Specify below)
2 PVC	4 ABS	6 Asbestos-Cement	8 Concrete Tile

Blank casing diameter 17 in. Was casing pulled? Yes No If yes, how much

Casing height above or below land surface in.

6 GROUT PLUG MATERIAL: 1 Neat cement 2 Cement grout Bentonite 4 Other

Grout Plug Intervals: From 3 ft. to 6 ft., From ft. to ft., From to ft.

What is the nearest source of possible contamination:

1 Septic tank	6 Seepage pit	11 Fuel storage	16 Other (specify below)
2 Sewer lines	7 Pit privy	12 Fertilizer storage
3 Watertight sewer lines	8 Sewage lagoon	13 Insecticide storage	
4 Lateral lines	9 Feedyard	14 Abandoned water well	
5 Cess Pool	10 Livestock pens	15 Oil well/Gas well	

Direction from well? How many feet?

FROM	TO	PLUGGING MATERIALS
<u>0</u>	<u>3</u>	<u>Soil</u>
<u>3</u>	<u>6</u>	<u>Bentonite</u>
<u>6</u>	<u>27</u>	<u>Clay Soil</u>
<u>27</u>	<u>51</u>	<u>Chlorinated Sand</u>

7 CONTRACTOR'S OR LANDOWNER'S CERTIFICATION: This water well was plugged under my jurisdiction and was completed on (mo/day/year) 03/17/06 and this record is true to the best of my knowledge and belief. Kansas Water Well Contractor's License No. This Water Well Record was completed on (mo/day/year) 03/17/06 under the business name of

by (signature) Lon V. Silver

INSTRUCTIONS: Use typewriter or ball point pen. Please press firmly and print clearly. Please fill in blanks, underline or circle the correct answers. Send top three copies to Kansas Department of Health and Environment, Bureau of Water, Topeka, Kansas 66620-0001. Telephone: 785/296-3565. Send one to Water Well Owner and retain one for your records.