

## WATER WELL PLUGGING RECORD Form WWC-5P

KSA 82a-1212

ID NO.

1 LOCATION OF WATER WELL: County: Clay Fraction NE 1/4 NE 1/4 NW 1/4 Section Number 36 Township Number 6 Range Number 2 E/W

Distance and direction from nearest town or city street address of well if located within city?

2 1/2 miles east and 2 miles north of Morganville2 WATER WELL OWNER: Bonnie MelliesRR#, St. Address, Box #: 1022 14th StCity, State ZIP Code: Clay Center KS 67432

Global Positioning Systems (decimal degrees, min. of 4 digits)

Latitude: \_\_\_\_\_

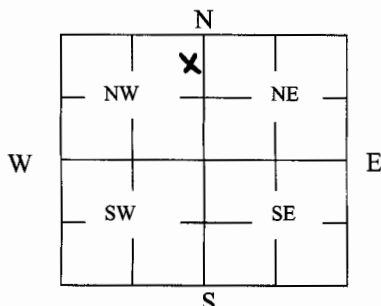
Longitude: \_\_\_\_\_

Elevation: \_\_\_\_\_

Datum: \_\_\_\_\_

Data Collection Method: \_\_\_\_\_

3 MARK WELL'S LOCATION WITH AN "X" IN SECTION BOX:

4 DEPTH OF WELL 19 ft.WELL'S STATIC WATER LEVEL 9 ft.

WELL WAS USED AS:

- ☒ 1 Domestic  
☐ 2 Irrigation  
☐ 3 Feedlot  
☐ 4 Industrial

- 5 Public Water Supply  
 6 Oil Field Water Supply  
 7 Domestic (Lawn & Garden)  
 8 Air Conditioning

- 9 Dewatering  
 10 Monitoring  
 11 Injection Well  
 12 Other \_\_\_\_\_

Was a chemical/bacteriological sample submitted to Department? Yes \_\_\_\_\_ No ☒

5 TYPE OF BLANK CASING USED:

- 1 Steel 3 RMP (SR) 5 Wrought 7 Fiberglass ☒ 9 Other (Specify below)  
 2 PVC 4 ABS 6 Asbestos-Cement 8 Concrete Tile Rock

Blank casing diameter 60 in. Was casing pulled? Yes \_\_\_\_\_ No ☒ If yes, how much \_\_\_\_\_

Casing height above or below land surface \_\_\_\_\_ in.

6 GROUT PLUG MATERIAL: 1 Neat cement 2 Cement grout ☒ 3 Bentonite 4 Other \_\_\_\_\_Grout Plug Intervals: From 4 1/2 ft. to 5 ft., From \_\_\_\_\_ ft. to \_\_\_\_\_ ft., From \_\_\_\_\_ to \_\_\_\_\_ ft.

What is the nearest source of possible contamination:

- 1 Septic tank 6 Seepage pit 11 Fuel Storage 16 Other (specify below)  
 2 Sewer lines 7 Pit privy 12 Fertilizer storage  
 3 Watertight sewer lines 8 Sewage lagoon 13 Insecticide storage  
 4 Lateral lines 9 Feedyard 14 Abandoned water well Direction from well? \_\_\_\_\_  
 5 Cess pool 10 Livestock pens 15 Oil well/Gas well How many feet? \_\_\_\_\_

FROM	TO	PLUGGING MATERIALS	FROM	TO	PLUGGING MATERIALS
<u>0</u>	<u>4 1/2</u>	<u>Soil</u>			
<u>4 1/2</u>	<u>5</u>	<u>Bentonite</u>			
<u>5</u>	<u>9</u>	<u>Clay Soil</u>			
<u>9</u>	<u>19</u>	<u>Chlorinated Sand</u>			

7 CONTRACTOR'S OR LANDOWNER'S CERTIFICATION: This water well was plugged under my jurisdiction and was completed on (mo/day/year) 04/17/08 and this record is true to the best of my knowledge and belief. Kansas Water Well Contractor's License No. \_\_\_\_\_. This Water Well Record was completed on (mo/day/year) 04/17/08 under the business name of \_\_\_\_\_ by (signature) Bonnie Mellies

INSTRUCTIONS: Use typewriter or ballpoint pen. Please press firmly and print clearly. Please fill in blanks, underline or circle the correct answers. Send top three copies to Kansas Department of Health and Environment, Bureau of Water, Geology Section, 1000 SW Jackson St., Ste. 420, Topeka, Kansas 66612-1367. Telephone: 785/296-5522. Send one to Water Well Owner and retain one for your records. Visit us at <http://www.kdheks.gov/geo/waterwells>.