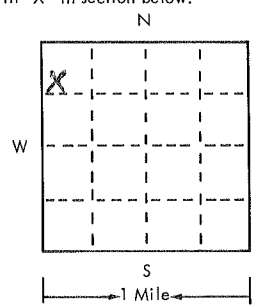


USE TYPEWRITER OR BALL POINT PEN—PRESS FIRMLY, PRINT CLEARLY.

T R EW sec 1/4 1/4 1/4 No.

WATER WELL RECORD
KSA 82a-1201-1215

Kansas State Dept. Of Health
(Water Well Contractors)
Forbes-Bldg. 740
Topeka, Kansas 66620

1 Location of well:	County CLAY	Township name SHERMAN	Fraction SWNW1/4	Section number 19	Town number 6	Range number 2 E
Distance and direction from nearest town or city: 1 E - 3 S - 1/2 W			3 Owner of well: LEO REED JR			
Street address of well location if in city: CLIFTON			Address: R-ROUTE CLIFTON, KANSAS 66937			
Locate with "X" in section below: 			Sketch map: THIS IS A STOCK WELL DRILLED CLOSE TO IRRIGATION WELL TO BE USED TO WATER STOCK IN OFF SEASON			4 Well depth: 60 ft. Date of completion _____ Well diameter 8 in. 12-1-78
2 Type and color of material			From	To	5 <input type="checkbox"/> Cable tool <input checked="" type="checkbox"/> Rotary <input type="checkbox"/> Driven <input type="checkbox"/> Dug <input type="checkbox"/> Hollow rod <input type="checkbox"/> Jetted <input type="checkbox"/> Bored <input type="checkbox"/> Reverse rotary	
			SAND	0	2	6 Use: <input type="checkbox"/> Domestic <input type="checkbox"/> Public supply <input type="checkbox"/> Industry <input type="checkbox"/> Irrigation <input type="checkbox"/> Air conditioning <input type="checkbox"/> Commercial <input type="checkbox"/> Test well <input checked="" type="checkbox"/> STOCK
SOFT CLAY			2	4	7 Casing: Material PVC Height: <u>above</u> /below Threaded <input type="checkbox"/> Welded <input checked="" type="checkbox"/> Surface 12 in. Diam. _____ Weight 3 lbs./ft. _____ 5 in. to 60 ft. depth Drive shoe? <input type="checkbox"/> Yes <input type="checkbox"/> No _____ in. to _____ ft. depth: 1258	
SAND			4	14	8 Screen: Manufacturer PUMPCO Type PVC Dia. 3" Slot/gauze 1/16 Length 20' Set between 40 ft. and 40 ft. _____ Fittings: Gravel pack <input checked="" type="checkbox"/> Yes <input type="checkbox"/> No Size range of material 1/8 x 1/4	
GRAVEL			14	60	9 Static water level: 16 ft. below land surface Date _____	
STOP			60		10 Pumping level below land surfaces: _____ ft. after 1/2 hrs. pumping _____ g.p.m. _____ ft. after 1/2 hrs. pumping _____ g.p.m. Estimated maximum yield 50 g.p.m.	
					11 Water sample submitted: <input type="checkbox"/> Yes <input checked="" type="checkbox"/> No Date _____	
					12 Well head completion: <input type="checkbox"/> Pitless adapter <input checked="" type="checkbox"/> Inches above grade	
					13 Well grouted? <input checked="" type="checkbox"/> Yes <input type="checkbox"/> No <input checked="" type="checkbox"/> Neat cement <input type="checkbox"/> Bentonite <input type="checkbox"/> _____ Depth: From 0 ft. to 10 ft.	
					14 Nearest source of possible contamination: ft. 1500 Direction WEST Type RIVER Well disinfected upon completion? <input checked="" type="checkbox"/> Yes <input type="checkbox"/> No	
					15 Pump: <input checked="" type="checkbox"/> Not installed Manufacturer's name _____ Model number _____ HP _____ Volts _____ Length of drop pipe _____ ft. capacity _____ g.m.p. Type: <input type="checkbox"/> Submersible <input type="checkbox"/> Turbine <input type="checkbox"/> Jet <input type="checkbox"/> Reciprocating <input type="checkbox"/> Centrifugal <input type="checkbox"/> Other	
16 Remarks: elevation					17 Water well contractor's certification: This well was drilled under my jurisdiction and this report is true to the best of my knowledge and belief. DARYL COX + SONS INC 359 Business name License No. _____ Address CLIFTON, KANS 66937 Signed Daryl Cox Date _____ Authorized representative 12-18-78	
Topography: <input type="checkbox"/> Hill <input type="checkbox"/> Slope <input type="checkbox"/> Upland <input checked="" type="checkbox"/> Valley						

6
2E
19
SWNW