

LOCATION OF WATER WELL
 County: Clay Fraction: SE 1/4 SE 1/4 SE 1/4 Section Number: 28 Township Number: T 16 S Range Number: R 2 E EW

Distance and direction from nearest town or city? 1 1/2 mile West of Epst Street address of well if located within city?
10 North of Clay Center

WATER WELL OWNER: Larry Thomas
 R#, St. Address, Box #: Route # 1 Board of Agriculture, Division of Water Resources
 City, State, ZIP Code: Clay Center, Kansas 67432 Application Number:

DEPTH OF COMPLETED WELL: 59 ft. Bore Hole Diameter: 8 in. to 59 ft., and _____ in. to _____ ft.

Well Water to be used as:
 1 Domestic 3 Feedlot 5 Public water supply 8 Air conditioning 11 Injection well
 2 Irrigation 4 Industrial 6 Oil field water supply 9 Dewatering 12 Other (Specify below)
 7 Lawn and garden only 10 Observation well

Well's static water level: 26 ft. below land surface measured on January month 8 day 1980 year

Pump Test Data: Well water was 40 ft. after 2 hours pumping 100 gpm
 Static Yield 150 gpm: Well water was _____ ft. after _____ hours pumping _____ gpm

TYPE OF BLANK CASING USED:
 1 Steel 3 RMP (SR) 5 Wrought iron 8 Concrete tile Casing Joints: Glued Clamped _____
 2 PVC 4 ABS 6 Asbestos-Cement 9 Other (specify below) Welded _____
 7 Fiberglass _____ Threaded _____

Blank casing dia: 5 in. to 39 ft., Dia _____ in. to _____ ft., Dia _____ in. to _____ ft.

Casing height above land surface: 12 in., weight 3 lbs./ft. Wall thickness or gauge No. 258

TYPE OF SCREEN OR PERFORATION MATERIAL:
 1 Steel 3 Stainless steel 5 Fiberglass 7 PVC 10 Asbestos-cement
 2 Brass 4 Galvanized steel 6 Concrete tile 8 RMP (SR) 11 Other (specify) _____
 9 ABS 12 None used (open hole)

Screen or Perforation Openings Are:
 1 Continuous slot 3 Mill slot 5 Gauzed wrapped 8 Saw cut 11 None (open hole)
 2 Louvered shutter 4 Key punched 6 Wire wrapped 9 Drilled holes
 7 Torch cut 10 Other (specify) _____

Screen-Perforation Dia: 5 in. to _____ ft., Dia _____ in. to _____ ft., Dia _____ in. to _____ ft.

Screen-Perforated Intervals:
 From 39 ft. to 59 ft., From _____ ft. to _____ ft., From _____ ft. to _____ ft.

Travel Pack Intervals:
 From 10 ft. to 59 ft., From _____ ft. to _____ ft., From _____ ft. to _____ ft.

GROUT MATERIAL: 1 Neat cement 2 Cement grout 3 Bentonite 4 Other

Grouted Intervals: From 0 ft. to 10 ft., From _____ ft. to _____ ft., From _____ ft. to _____ ft.

What is the nearest source of possible contamination: None
 1 Septic tank 4 Cess pool 7 Sewage lagoon 11 Fertilizer storage 14 Abandoned water well
 2 Sewer lines 5 Seepage pit 8 Feed yard 12 Insecticide storage 15 Oil well/Gas well
 3 Lateral lines 6 Pit privy 9 Livestock pens 13 Watertight sewer lines 16 Other (specify below)

Direction from well _____ How many feet _____? Water Well Disinfected? Yes No

Has a chemical/bacteriological sample submitted to Department? Yes _____ No If yes, date sample submitted _____ month _____ day _____ year Pump Installed? Yes _____ No

Yes: Pump Manufacturer's name _____ Model No. _____ HP _____ Volts _____


Depth of Pump Intake _____ ft. Pumps Capacity rated at _____ gal./min.

Type of pump: 1 Submersible 2 Turbine 3 Jet 4 Centrifugal 5 Reciprocating 6 Other

CONTRACTOR'S OR LANDOWNER'S CERTIFICATION: This water well was (1) constructed, (2) reconstructed, or (3) plugged under my jurisdiction and was completed on January month 8 day 1980 year

and this record is true to the best of my knowledge and belief. Kansas Water Well Contractor's License No. 361

This Water Well Record was completed on January month 9 day 1980 year under the business name of Cox - Beswick Irrigation Service, Inc. by (signature) Thomas Cox

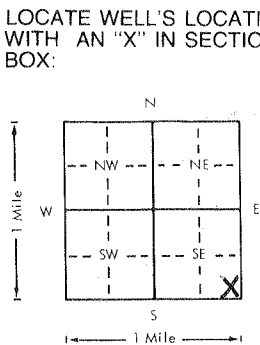

FROM	TO	LITHOLOGIC LOG	FROM	TO	LITHOLOGIC LOG
0	23	top soil & clay			
23	28	sand			
28	60	gravel			
60		stop in gravel			

ELEVATION: _____

Depth(s) Groundwater Encountered 1. 23 ft. 2. _____ ft. 3. _____ ft. 4. _____ ft. (Use a second sheet if needed)

INSTRUCTIONS: Use typewriter or ball point pen, please press firmly and PRINT clearly. Please fill in blanks, underline or circle the correct answers. Send top three copies to Kansas Department of Health and Environment, Division of Environment, Water Well Contractors, Topeka, KS 66620. Send one to WATER WELL OWNER and retain one for your records.