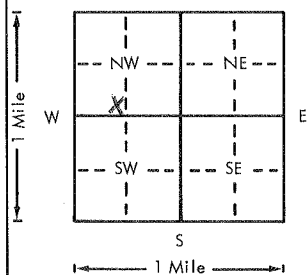


USE TYPEWRITER OR BALL  
POINT PEN-PRESS FIRMLY,  
PRINT CLEARLY.

WATER WELL RECORD  
KSA 82a-1201-1215

Kansas Department of Health and  
Environment-Division of Environment  
(Water well Contractors)  
Topeka, Kansas 66620

1. Location of well:		County <b>CLAY</b>	Fraction <b>SE 1/4 SW 1/4 NW 1/4</b>	Section number <b>33</b>	Township number <b>T 6 S R 2</b>	Range number <b>2</b>		
2. Distance and direction from nearest town or city: <b>1 1/2 W OF MORGANVILLE</b>			3. Owner of well: <b>BILL SILVERS</b> R.R. or street: City, state, zip code: <b>MORGANVILLE KS 67468</b>					
4. Locate with "X" in section below: 			Sketch map:		6. Bore hole dia. <b>3 1/2</b> in. Completion date <b>12-3-76</b> Well depth <b>72 1/2</b> ft.			
5. Type and color of material			From		To			
			Top soil + clay		0	21		
			SAND		21	30		
			CLAY		30	38		
			SAND		38	40		
			GOOD GRAVEL		40	72		
			SHALE		72			
18. Elevation:			19. Remarks: <b>OWNERS - BILL SILVERS MORGANVILLE, KS</b> <b>MRS. JEAN FROSS</b> <b>1100 E. FAIR HAVEN</b> <b>SANTA ANTA, CALIF. 92701</b>			20. Water well contractor's certification: This well was drilled under my jurisdiction and this report is true to the best of my knowledge and belief. <b>GEO COX &amp; SONS, INC 258</b> Business name License No. Address <b>CLIFTON, KS. 66937</b> Signed <b>James Cox</b> Date <b>12-24-76</b> Authorized representative		

Forward the white, blue and pink copies to the Department of Health and Environment

Form WWC-5