


1 LOCATION OF WATER WELL: Fraction  $\frac{1}{4}$  SW  $\frac{1}{4}$  NW  $\frac{1}{4}$  Section Number 1 Township Number T 6 S Range Number R 20 E

Distance and direction from nearest town or city street address of well if located within city?  
 Approx 375' south of main = 150' west of 13<sup>th</sup> street

2 WATER WELL OWNER: Midwest Grain  
 RR#, St. Address, Box #: 1300 main  
 City, State, ZIP Code: Atchison Ks.  
 Board of Agriculture, Division of Water Resources  
 Application Number:

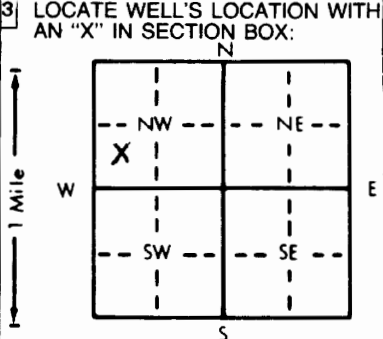

4 DEPTH OF COMPLETED WELL: 27.5 ft. ELEVATION: N/A  
 Depth(s) Groundwater Encountered 1. 14.0 ft. 2. — ft. 3. — ft.  
 WELL'S STATIC WATER LEVEL: 14.0 ft. below land surface measured on mo/day/yr 7/20/92  
 Pump test data: Well water was — ft. after — hours pumping — gpm  
 Est. Yield — gpm; Well water was — ft. after — hours pumping — gpm  
 Bore Hole Diameter: 6 in. to — ft., and — in. to — ft.  
 WELL WATER TO BE USED AS:  
 5 Public water supply 8 Air conditioning 11 Injection well  
 1 Domestic 3 Feedlot 6 Oil field water supply 9 Dewatering 12 Other (Specify below)  
 2 Irrigation 4 Industrial 7 Lawn and garden only 10 Monitoring well  
 Was a chemical/bacteriological sample submitted to Department? Yes.....No...X..... If yes, mo/day/yr sample was submitted  
 Water Well Disinfected? Yes No X

5 TYPE OF BLANK CASING USED:  
 1 Steel 3 RMP (SR) 5 Wrought iron 8 Concrete tile CASING JOINTS: Glued.....Clamped.....  
 2 PVC 4 ABS 6 Asbestos-Cement 9 Other (specify below) Welded.....  
 7 Fiberglass Threaded.....X  
 Blank casing diameter: 2 in. to 12 ft., Dia. — in. to — ft., Dia. — in. to — ft.  
 Casing height above land surface: 0.0 in., weight Sch 40 lbs./ft. Wall thickness or gauge No. —  
 TYPE OF SCREEN OR PERFORATION MATERIAL:  
 1 Steel 3 Stainless steel 5 Fiberglass 8 RMP (SR) 10 Asbestos-cement  
 2 Brass 4 Galvanized steel 6 Concrete tile 9 ABS 11 Other (specify).....  
 12 None used (open hole)  
 SCREEN OR PERFORATION OPENINGS ARE:  
 1 Continuous slot 3 Mill slot 5 Gauzed wrapped 8 Saw cut 11 None (open hole)  
 2 Louvered shutter 4 Key punched 6 Wire wrapped 9 Drilled holes  
 7 Torch cut 10 Other (specify).....  
 SCREEN-PERFORATED INTERVALS: From 12.0 ft. to 27.0 ft., From — ft. to — ft.  
 From — ft. to — ft., From — ft. to — ft.  
 GRAVEL PACK INTERVALS: From 10.0 ft. to 27.5 ft., From — ft. to — ft.  
 From — ft. to — ft., From — ft. to — ft.

6 GROUT MATERIAL: 1 Neat cement 2 Cement grout 3 Bentonite 4 Other.....  
 Grout Intervals: From 0.0 ft. to 12.0 ft., From — ft. to — ft., From — ft. to — ft.  
 What is the nearest source of possible contamination:  
 1 Septic tank 4 Lateral lines 7 Pit privy 10 Livestock pens 14 Abandoned water well  
 2 Sewer lines 5 Cess pool 8 Sewage lagoon 11 Fuel storage 15 Oil well/Gas well  
 3 Watertight sewer lines 6 Seepage pit 9 Feedyard 12 Fertilizer storage 16 Other (specify below)  
 13 Insecticide storage  
 Direction from well? How many feet?

FROM	TO	LITHOLOGIC LOG	FROM	TO	PLUGGING INTERVALS
0.0	0.5	Concrete			
0.5	7.0	Silty clay Dark Brown			
7.0	8.0	Silty clay Dark Gray			
8.0	26.5	Silty clay Dark Olive Gray			
26.5	27.5	Silty clay Dark Olive Gray w/CSG			

7 CONTRACTOR'S OR LANDOWNER'S CERTIFICATION: This water well was (1) constructed, (2) reconstructed, or (3) plugged under my jurisdiction and was completed on (mo/day/year) 7/20/92 and this record is true to the best of my knowledge and belief. Kansas Water Well Contractor's License No. 410 This Water Well Record was completed on (mo/day/yr) 7/29/92 under the business name of Terracon Consultants Inc by (signature) Richard D. Murphy

OFFICE USE ONLY  
T  
R  
EW  
SEC.