


1 LOCATION OF WATER WELL: Fraction $\frac{1}{4}$ SW $\frac{1}{4}$ NW $\frac{1}{4}$ Section Number 1 Township Number T 6 S Range Number R 20 E

Distance and direction from nearest town or city street address of well if located within city?
 Approx 450' South of Main and 800' W of 13th Street

2 WATER WELL OWNER: Midwest Grain
 RR#, St. Address, Box #: 1300 Main
 City, State, ZIP Code: Atchison KS
 Board of Agriculture, Division of Water Resources
 Application Number:

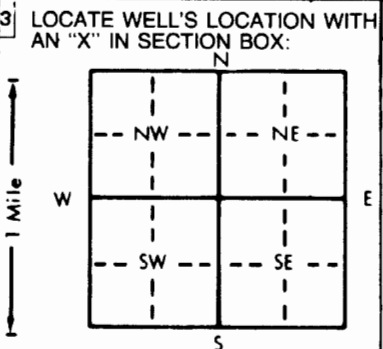

4 DEPTH OF COMPLETED WELL: 30.0 ft. ELEVATION: N/A
 Depth(s) Groundwater Encountered 1. Dry ft. 2. — ft. 3. — ft.
 WELL'S STATIC WATER LEVEL: -9.99 ft. below land surface measured on mo/day/yr
 Pump test data: Well water was — ft. after — hours pumping — gpm
 Est. Yield — gpm; Well water was — ft. after — hours pumping — gpm
 Bore Hole Diameter: 6" in. to 30.0 ft., and — in. to — ft.
 WELL WATER TO BE USED AS:
 5 Public water supply 8 Air conditioning 11 Injection well
 1 Domestic 3 Feedlot 6 Oil field water supply 9 Dewatering 12 Other (Specify below)
 2 Irrigation 4 Industrial 7 Lawn and garden only 10 Monitoring well
 Was a chemical/bacteriological sample submitted to Department? Yes No If yes, mo/day/yr sample was submitted
 Water Well Disinfected? Yes No

5 TYPE OF BLANK CASING USED:
 1 Steel 3 RMP (SR) 5 Wrought iron 8 Concrete tile CASING JOINTS: Glued Clamped
 2 PVC 4 ABS 6 Asbestos-Cement 9 Other (specify below) Welded
 7 Fiberglass Threaded
 Blank casing diameter: 2 in. to 10.0 ft., Dia. — in. to — ft., Dia. — in. to — ft.
 Casing height above land surface: 0.0 in., weight: Sch 40 lbs./ft. Wall thickness or gauge No. —
 TYPE OF SCREEN OR PERFORATION MATERIAL:
 1 Steel 3 Stainless steel 5 Fiberglass 8 RMP (SR) 10 Asbestos-cement
 2 Brass 4 Galvanized steel 6 Concrete tile 9 ABS 12 None used (open hole)
 SCREEN OR PERFORATION OPENINGS ARE:
 1 Continuous slot 3 Mill slot 5 Gauzed wrapped 8 Saw cut 11 None (open hole)
 2 Louvered shutter 4 Key punched 6 Wire wrapped 9 Drilled holes
 7 Torch cut 10 Other (specify)
 SCREEN-PERFORATED INTERVALS: From 10.0 ft. to 30.0 ft., From — ft. to — ft.
 GRAVEL PACK INTERVALS: From 8.0 ft. to 30.0 ft., From — ft. to — ft.

6 GROUT MATERIAL: 1 Neat cement 2 Cement grout 3 Bentonite 4 Other
 Grout Intervals: From 0.0 ft. to 8.0 ft., From — ft. to — ft., From — ft. to — ft.
 What is the nearest source of possible contamination:
 1 Septic tank 4 Lateral lines 7 Pit privy 10 Livestock pens 14 Abandoned water well
 2 Sewer lines 5 Cess pool 8 Sewage lagoon 11 Fuel storage 15 Oil well/Gas well
 3 Watertight sewer lines 6 Seepage pit 9 Feedyard 12 Fertilizer storage 16 Other (specify below)
 13 Insecticide storage
 Direction from well? How many feet?

FROM	TO	LITHOLOGIC LOG	FROM	TO	PLUGGING INTERVALS
0.0	→	(Fill) Gravel, Silty clay cinders			
→	7.5	coal, sand & Brick Fragments			
7.5	→	(Poss Fill) Silty clay w/			
→	12.0	Fine-Coarse Sand			
12.0	16.0	Silty clay Brown			
16.0	17.0	Silty clay Olive Gray			
17.0	30.0	Silty clay Brown			

7 CONTRACTOR'S OR LANDOWNER'S CERTIFICATION: This water well was 1 constructed, (2) reconstructed, or (3) plugged under my jurisdiction and was completed on (mo/day/year) 7/20/92 and this record is true to the best of my knowledge and belief. Kansas Water Well Contractor's License No. 416 This Water Well Record was completed on (mo/day/yr) 7/29/92 under the business name of Terracon Consultants Inc by (signature) Richard P. Murphy

OFFICE USE ONLY
T
R
EW
SEC.
1/4
1/4
1/4