


1 LOCATION OF WATER WELL: Fraction NE 1/4 SW 1/4 NW 1/4 Section Number 1 Township Number T 6 S Range Number R 20 EW
 County: Atchison

Distance and direction from nearest town or city street address of well if located within city?
Approx 300' South of Main and 200' West of 13th Street

2 WATER WELL OWNER: Midwest Grain Board of Agriculture, Division of Water Resources
 RR#, St. Address, Box #: 1300 Main Application Number:
 City, State, ZIP Code: Atchison KS

3 LOCATE WELL'S LOCATION WITH AN "X" IN SECTION BOX:

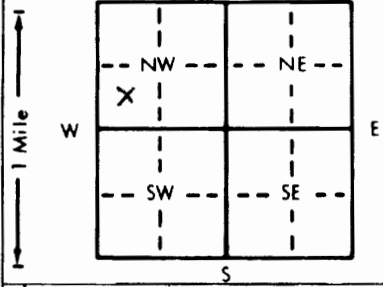

4 DEPTH OF COMPLETED WELL: 25 ft. ELEVATION: N/A
 Depth(s) Groundwater Encountered 1. Dry ft. 2. — ft. 3. — ft.
 WELL'S STATIC WATER LEVEL Dry ft. below land surface measured on mo/day/yr —

Pump test data: Well water was — ft. after — hours pumping — gpm
 Est. Yield — gpm: Well water was — ft. after — hours pumping — gpm
 Bore Hole Diameter 6" in. to 25.0 ft., and — in. to — ft.

WELL WATER TO BE USED AS:
 5 Public water supply 8 Air conditioning 11 Injection well
 1 Domestic 3 Feedlot 6 Oil field water supply 9 Dewatering 12 Other (Specify below)
 2 Irrigation 4 Industrial 7 Lawn and garden only 10 Monitoring well
 Was a chemical/bacteriological sample submitted to Department? Yes — No X; If yes, mo/day/yr sample was submitted —
 Water Well Disinfected? Yes — No X

5 TYPE OF BLANK CASING USED:
 1 Steel 3 RMP (SR) 5 Wrought iron 8 Concrete tile CASING JOINTS: Glued — Clamped —
2 PVC 4 ABS 6 Asbestos-Cement 9 Other (specify below) Welded —
 7 Fiberglass Threaded X

Blank casing diameter 8" in. to 10.0 ft., Dia — in. to — ft., Dia — in. to — ft.
 Casing height above land surface 0.0 in., weight 5 sch 40 lbs./ft. Wall thickness or gauge No. —

TYPE OF SCREEN OR PERFORATION MATERIAL:
 1 Steel 3 Stainless steel 5 Fiberglass 8 RMP (SR) 10 Asbestos-cement
 2 Brass 4 Galvanized steel 6 Concrete tile 9 ABS 11 Other (specify) —
 12 None used (open hole)

SCREEN OR PERFORATION OPENINGS ARE:
 1 Continuous slot 3 Mill slot 5 Gauzed wrapped 8 Saw cut 11 None (open hole)
 2 Louvered shutter 4 Key punched 6 Wire wrapped 9 Drilled holes
 7 Torch cut 10 Other (specify) —

SCREEN-PERFORATED INTERVALS: From 10.0 ft. to 25.0 ft., From — ft. to — ft., From — ft. to — ft.
 From — ft. to — ft., From — ft. to — ft., From — ft. to — ft.
 GRAVEL PACK INTERVALS: From 8.0 ft. to 25.0 ft., From — ft. to — ft., From — ft. to — ft.
 From — ft. to — ft., From — ft. to — ft., From — ft. to — ft.

6 GROUT MATERIAL: 1 Neat cement 2 Cement grout 3 Bentonite 4 Other —
 Grout Intervals: From 0.0 ft. to 5.0 ft., From — ft. to — ft., From — ft. to — ft., From — ft. to — ft.

What is the nearest source of possible contamination:
 1 Septic tank 4 Lateral lines 7 Pit privy 11 Fuel storage 14 Abandoned water well
 2 Sewer lines 5 Cess pool 8 Sewage lagoon 12 Fertilizer storage 15 Oil well/Gas well
 3 Watertight sewer lines 6 Seepage pit 9 Feedyard 13 Insecticide storage 16 Other (specify below) —

Direction from well? How many feet?

FROM	TO	LITHOLOGIC LOG	FROM	TO	PLUGGING INTERVALS
<u>0.0</u>	<u>→</u>	<u>(Fill) Gravel, Brick, slag, cinders</u>			
<u>→</u>	<u>11.0</u>	<u>w/size 8 gr Brown</u>			
<u>11.0</u>	<u>14.5</u>	<u>Silty clay Brown Gray Yell</u>			
<u>14.5</u>	<u>25.0</u>	<u>Shale Olive Gray</u>			

7 CONTRACTOR'S OR LANDOWNER'S CERTIFICATION: This water well was 1 constructed, (2) reconstructed, or (3) plugged under my jurisdiction and was completed on (mo/day/year) 7/20/92 and this record is true to the best of my knowledge and belief. Kansas Water Well Contractor's License No. 416 This Water Well Record was completed on (mo/day/yr) 7/28/92 under the business name of Terracon Consultants Inc by (signature) Richard D Murphy