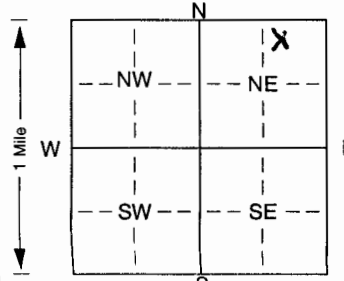


1 LOCATION OF WATER WELL: Fraction NW ¼ NE ¼ NE ¼ Section Number 10 Township Number T 6 S Range Number R 20 EW  
 County: Atchison

Distance and direction from nearest town or city street address of well if located within city? St. address  
1 mile West of Atchison From Jct. of Hwy 73+59 and 150' North of 59 Hwy approx. @ 10718 US Hwy 59

2 WATER WELL OWNER: Mike Smith  
 RR#, St. Address, Box #: 10718 US Hwy 59 Board of Agriculture, Division of Water Resources  
 City, State, ZIP Code: Atchison, KS 66002 Application Number:

3 LOCATE WELL'S LOCATION WITH AN "X" IN SECTION BOX:  4 DEPTH OF COMPLETED WELL: 49 ft. ELEVATION:  
 Depth(s) Groundwater Encountered 1. 25 ft. 2. ft. 3. ft.  
 WELL'S STATIC WATER LEVEL 15 ft. below land surface measured on mo/day/yr 5-15-05  
 Pump test data: Well water was ft. after hours pumping gpm  
 Est. Yield 15 gpm: Well water was ft. after hours pumping gpm  
 Bore Hole Diameter. 9.76 in. to ft., and in. to ft.  
 WELL WATER TO BE USED AS: 5 Public water supply 8 Air conditioning 11 Injection well  
1 Domestic 3 Feedlot 6 Oil field water supply 9 Dewatering 12 Other (Specify below)  
2 Irrigation 4 Industrial 7 Domestic (lawn & garden) 10 Monitoring well and Shop  
 Was a chemical/bacteriological sample submitted to Department? Yes. No. X; If yes, mo/day/yr sample was submitted Water Well Disinfected? Yes X No

5 TYPE OF BLANK CASING USED: 5 Wrought iron 8 Concrete tile CASING JOINTS: Glued. X Clamped. Welded. Threaded.  
1 Steel 3 RMP (SR) 6 Asbestos-Cement 9 Other (specify below)  
2 PVC 4 ABS 7 Fiberglass  
 Blank casing diameter 5 in. to 29 ft., Dia in. to ft., Dia in. to ft.  
 Casing height above land surface. 24 in., weight 2.87 lbs./ft. Wall thickness or gauge No. SDR 21  
 TYPE OF SCREEN OR PERFORATION MATERIAL: 7 PVC 10 Asbestos-cement  
1 Steel 3 Stainless steel 5 Fiberglass 8 RMP (SR) 11 Other (specify)  
2 Brass 4 Galvanized steel 6 Concrete tile 9 ABS 12 None used (open hole)  
 SCREEN OR PERFORATION OPENINGS ARE: 5 Gauzed wrapped 8 Saw cut 11 None (open hole)  
1 Continuous slot 3 Mill slot 6 Wire wrapped 9 Drilled holes  
2 Louvered shutter 4 Key punched 7 Torch cut 10 Other (specify) ft.  
 SCREEN-PERFORATED INTERVALS: From 29 ft. to 49 ft., From ft. to ft.  
 From ft. to ft., From ft. to ft.  
 GRAVEL PACK INTERVALS: From 23 ft. to 49 ft., From ft. to ft.  
 From ft. to ft., From ft. to ft.

6 GROUT MATERIAL: 1 Neat cement 2 Cement grout 3 Bentonite 4 Other  
 Grout Intervals: From 0.5 ft. to 23 ft., From ft. to ft., From ft. to ft.  
 What is the nearest source of possible contamination:  
1 Septic tank 4 Lateral lines 7 Pit privy 10 Livestock pens 14 Abandoned water well  
 2 Sewer lines 5 Cess pool 8 Sewage lagoon 11 Fuel storage 15 Oil well/Gas well  
 3 Watertight sewer lines 6 Seepage pit 9 Feedyard 12 Fertilizer storage 16 Other (specify below)  
Existing Well

Direction from well? (Septic Tank Southwest) (Existing Well Southeast) How many feet? (Septic Tank 67') (Well 28')

FROM	TO	LITHOLOGIC LOG	FROM	TO	PLUGGING INTERVALS
0	18	Brown Clay			
18	19	Sandy Brown-Grey Clay			
19	25	Sandy Brown Clay			
25	32	Grey Silty Clay			
32	35	Grey Fine Sand			
35	36	Grey Med. Sand			
36	39	Grey Med. Sand + Wood Debris			
39	42	Grey Med. Sand			
42	46	Grey Fine Sand			
46	49	Grey Med. Sand + Boulder / Fractured Rock			
49	52	Grey Med. Sand			
52	55	Shale - grey			
55	55	Rock			

7 CONTRACTOR'S OR LANDOWNER'S CERTIFICATION: This water well was (1) constructed, (2) reconstructed, or (3) plugged under my jurisdiction and was completed on (mo/day/year) 5-14-05 and this record is true to the best of my knowledge and belief. Kansas Water Well Contractor's Licence No. 739 This Water Well Record was completed on (mo/day/yr) 5-20-05 under the business name of Rork Drilling by (signature) Mike Rork