


1 LOCATION OF WATER WELL: County: <u>Atchison</u>	Fraction <u>SE 1/4 SW 1/4 NE 1/4</u>	Section Number <u>1</u>	Township Number <u>6 S</u>	Range Number <u>20 E</u>
--	---	----------------------------	-------------------------------	-----------------------------

Distance and direction from nearest town or city street address of well if located within city?  
1008 + 1014 Gasoline Alley / Atchison, KS

2 WATER WELL OWNER: <u>Exxon Mobil Refining + Supply</u> RR #, St. Address, Box #: <u>1001 Wampanoag Trail</u> City, State, ZIP Code : <u>Riverside, RI 02915</u>	1 Well Board of Agriculture, Division of Water Resources Application Number:
---	--

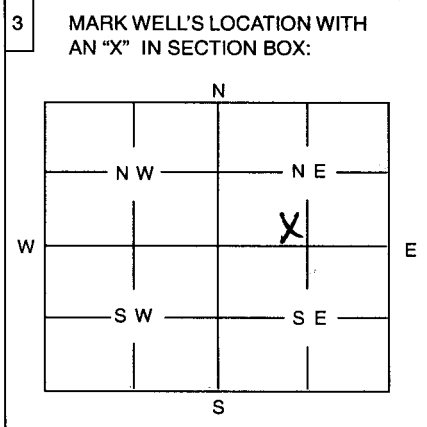

4 DEPTH OF WELL ..... 24 ..... ft

WELL'S STATIC WATER LEVEL ..... ft.

WELL WAS USED AS:

1 Domestic	5 Public Water Supply	9 Dewatering
2 Irrigation	6 Oil Field Water Supply	<u>10 Monitoring Well</u>
3 Feedlot	7 Domestic (Lawn & Garden)	11 Injection Well
4 Industrial	8 Air Conditioning	12 Other .....

Was a chemical / bacteriological sample submitted to Department? Yes ..... No .....

If yes, mo/day/yr sample was submitted .....

Water Well Disinfected: Yes ..... No .....

5 TYPE OF CASING USED:

1 Steel    3 RMP (SR)    5 Wrought    7 Fiberglass    9 Other (Specify below)

2 PVC    4 ABS    6 Asbestos-Cement    8 Concrete Tile

Blank casing diameter ..... 4 ..... in.    Was casing pulled?    Yes X    No .....

Casing height above or below land surface ..... 30 ..... in.    If yes, how much All

6 GROUT PLUG MATERIAL:    1 Neat cement    2 Cement grout    3 Bentonite    4 Other .....

GROUT PLUG INTERVALS:    From ..... ft. to ..... 24 ..... ft.,    From ..... ft. to ..... ft.,    From ..... ft. to ..... ft.

What is the nearest source of possible contamination:

1 Septic tank	6 Seepage pit	<u>11 Fuel storage</u>	16 Other (specify below)
2 Sewer lines	7 Pit privy	12 Fertilizer storage	.....
3 Watertight sewer lines	8 Sewage lagoon	13 Insecticide storage	
4 Lateral lines	9 Feedyard	14 Abandoned water well	
5 Cess Pool	10 Livestock pens	15 Oil well/Gas well	

Direction from well? West    How many feet? 200

FROM	TO	PLUGGING MATERIALS
<u>0</u>	<u>3</u>	<u>Soil</u>
<u>3</u>	<u>24</u>	<u>3/8" Bentonite Chips</u>

7 CONTRACTOR'S OR LANDOWNER'S CERTIFICATION: This water well was plugged under my jurisdiction and was completed on (mo/day/year) ..... 3/2/06 ..... and this record is true to the best of my knowledge and belief. Kansas Water Well Contractor's License No. 676 This Water Well Record was completed on (mo/day/year) 3/27/06 under the business name of Whitetail Drilling, LLC by (signature) Andy Baw

INSTRUCTIONS: Use typewriter or ball point pen. Please press firmly and print clearly. Please fill in blanks, underline or circle the correct answers. Send top three copies to Kansas Department of Health and Environment, Bureau of Water, Topeka, Kansas 66620-0001. Telephone: 785/296-3565. Send one to Water Well Owner and retain one for your records.