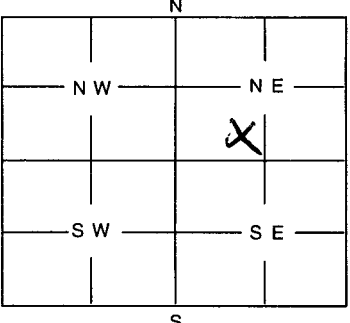


1	LOCATION OF WATER WELL: County: <u>Atchison</u>	Fraction <u>SE 1/4 SW 1/4 NE 1/4</u>	Section <u>1</u>	Number	Township <u>6 S</u>	Number	Range <u>20 E</u>	Number
---	--	---	---------------------	--------	------------------------	--------	----------------------	--------

Distance and direction from nearest town or city street address of well if located within city?
1008 + 1014 Gasoline Alley / Atchison, KS

2	WATER WELL OWNER: <u>Exxon Mobil Refining & Supply</u> RR #, St. Address, Box #: <u>1001 Wampanoag Trail</u> City, State, ZIP Code: <u>Riverside, RI 02915</u>	<u>4 Wells</u> Board of Agriculture, Division of Water Resources Application Number:
---	--	--

3	MARK WELL'S LOCATION WITH AN "X" IN SECTION BOX: 	4	DEPTH OF WELL <u>32</u> ft. WELL'S STATIC WATER LEVEL ft. WELL WAS USED AS: 1 Domestic 2 Irrigation 3 Feedlot 4 Industrial 5 Public Water Supply 6 Oil Field Water Supply 7 Domestic (Lawn & Garden) 8 Air Conditioning 9 Dewatering 10 <u>Monitoring Well</u> 11 Injection Well 12 Other
---	--	---	---

Was a chemical / bacteriological sample submitted to Department? Yes No
If yes, mo/day/yr sample was submitted

Water Well Disinfected: Yes No

5	TYPE OF BLANK CASING USED: 1 Steel <u>2 PVC</u> 3 RMP (SR) 4 ABS 5 Wrought 6 Asbestos-Cement 7 Fiberglass 8 Concrete Tile 9 Other (Specify below)	Blank casing diameter <u>4</u> in. Casing height above or below land surface <u>30</u> in.	Was casing pulled? Yes <u>X</u> No If yes, how much <u>All</u>
---	--	---	---

6	GROUT PLUG MATERIAL: 1 Neat cement 2 Cement grout <u>3 Bentonite</u> 4 Other	Grout Plug Intervals: From <u>3</u> ft. to <u>32</u> ft., From ft. to ft., From to ft.
---	--	--

What is the nearest source of possible contamination:
1 Septic tank 2 Sewer lines 3 Watertight sewer lines 4 Lateral lines 5 Cess Pool
6 Seepage pit 7 Pit privy 8 Sewage lagoon 9 Feedyard 10 Livestock pens
11 Fuel storage 12 Fertilizer storage 13 Insecticide storage 14 Abandoned water well 15 Oil well/Gas well 16 Other (specify below)

Direction from well? West How many feet? 200

FROM	TO	PLUGGING MATERIALS
<u>0</u>	<u>3</u>	<u>Soil</u>
<u>3</u>	<u>32</u>	<u>3/8" Bentonite Chips</u>

7	CONTRACTOR'S OR LANDOWNER'S CERTIFICATION: This water well was plugged under my jurisdiction and was completed on (mo/day/year) <u>3/27/06</u> and this record is true to the best of my knowledge and belief. Kansas Water Well Contractor's License No. <u>676</u> This Water Well Record was completed on (mo/day/year) <u>3/27/06</u> under the business name of <u>Whitetail Drilling, LLC</u> by (signature) <u>Chris Baird</u>
---	--

INSTRUCTIONS: Use typewriter or ball point pen. Please press firmly and print clearly. Please fill in blanks, underline or circle the correct answers. Send top three copies to Kansas Department of Health and Environment, Bureau of Water, Topeka, Kansas 66620-0001. Telephone: 785/296-3565. Send one to Water Well Owner and retain one for your records.